
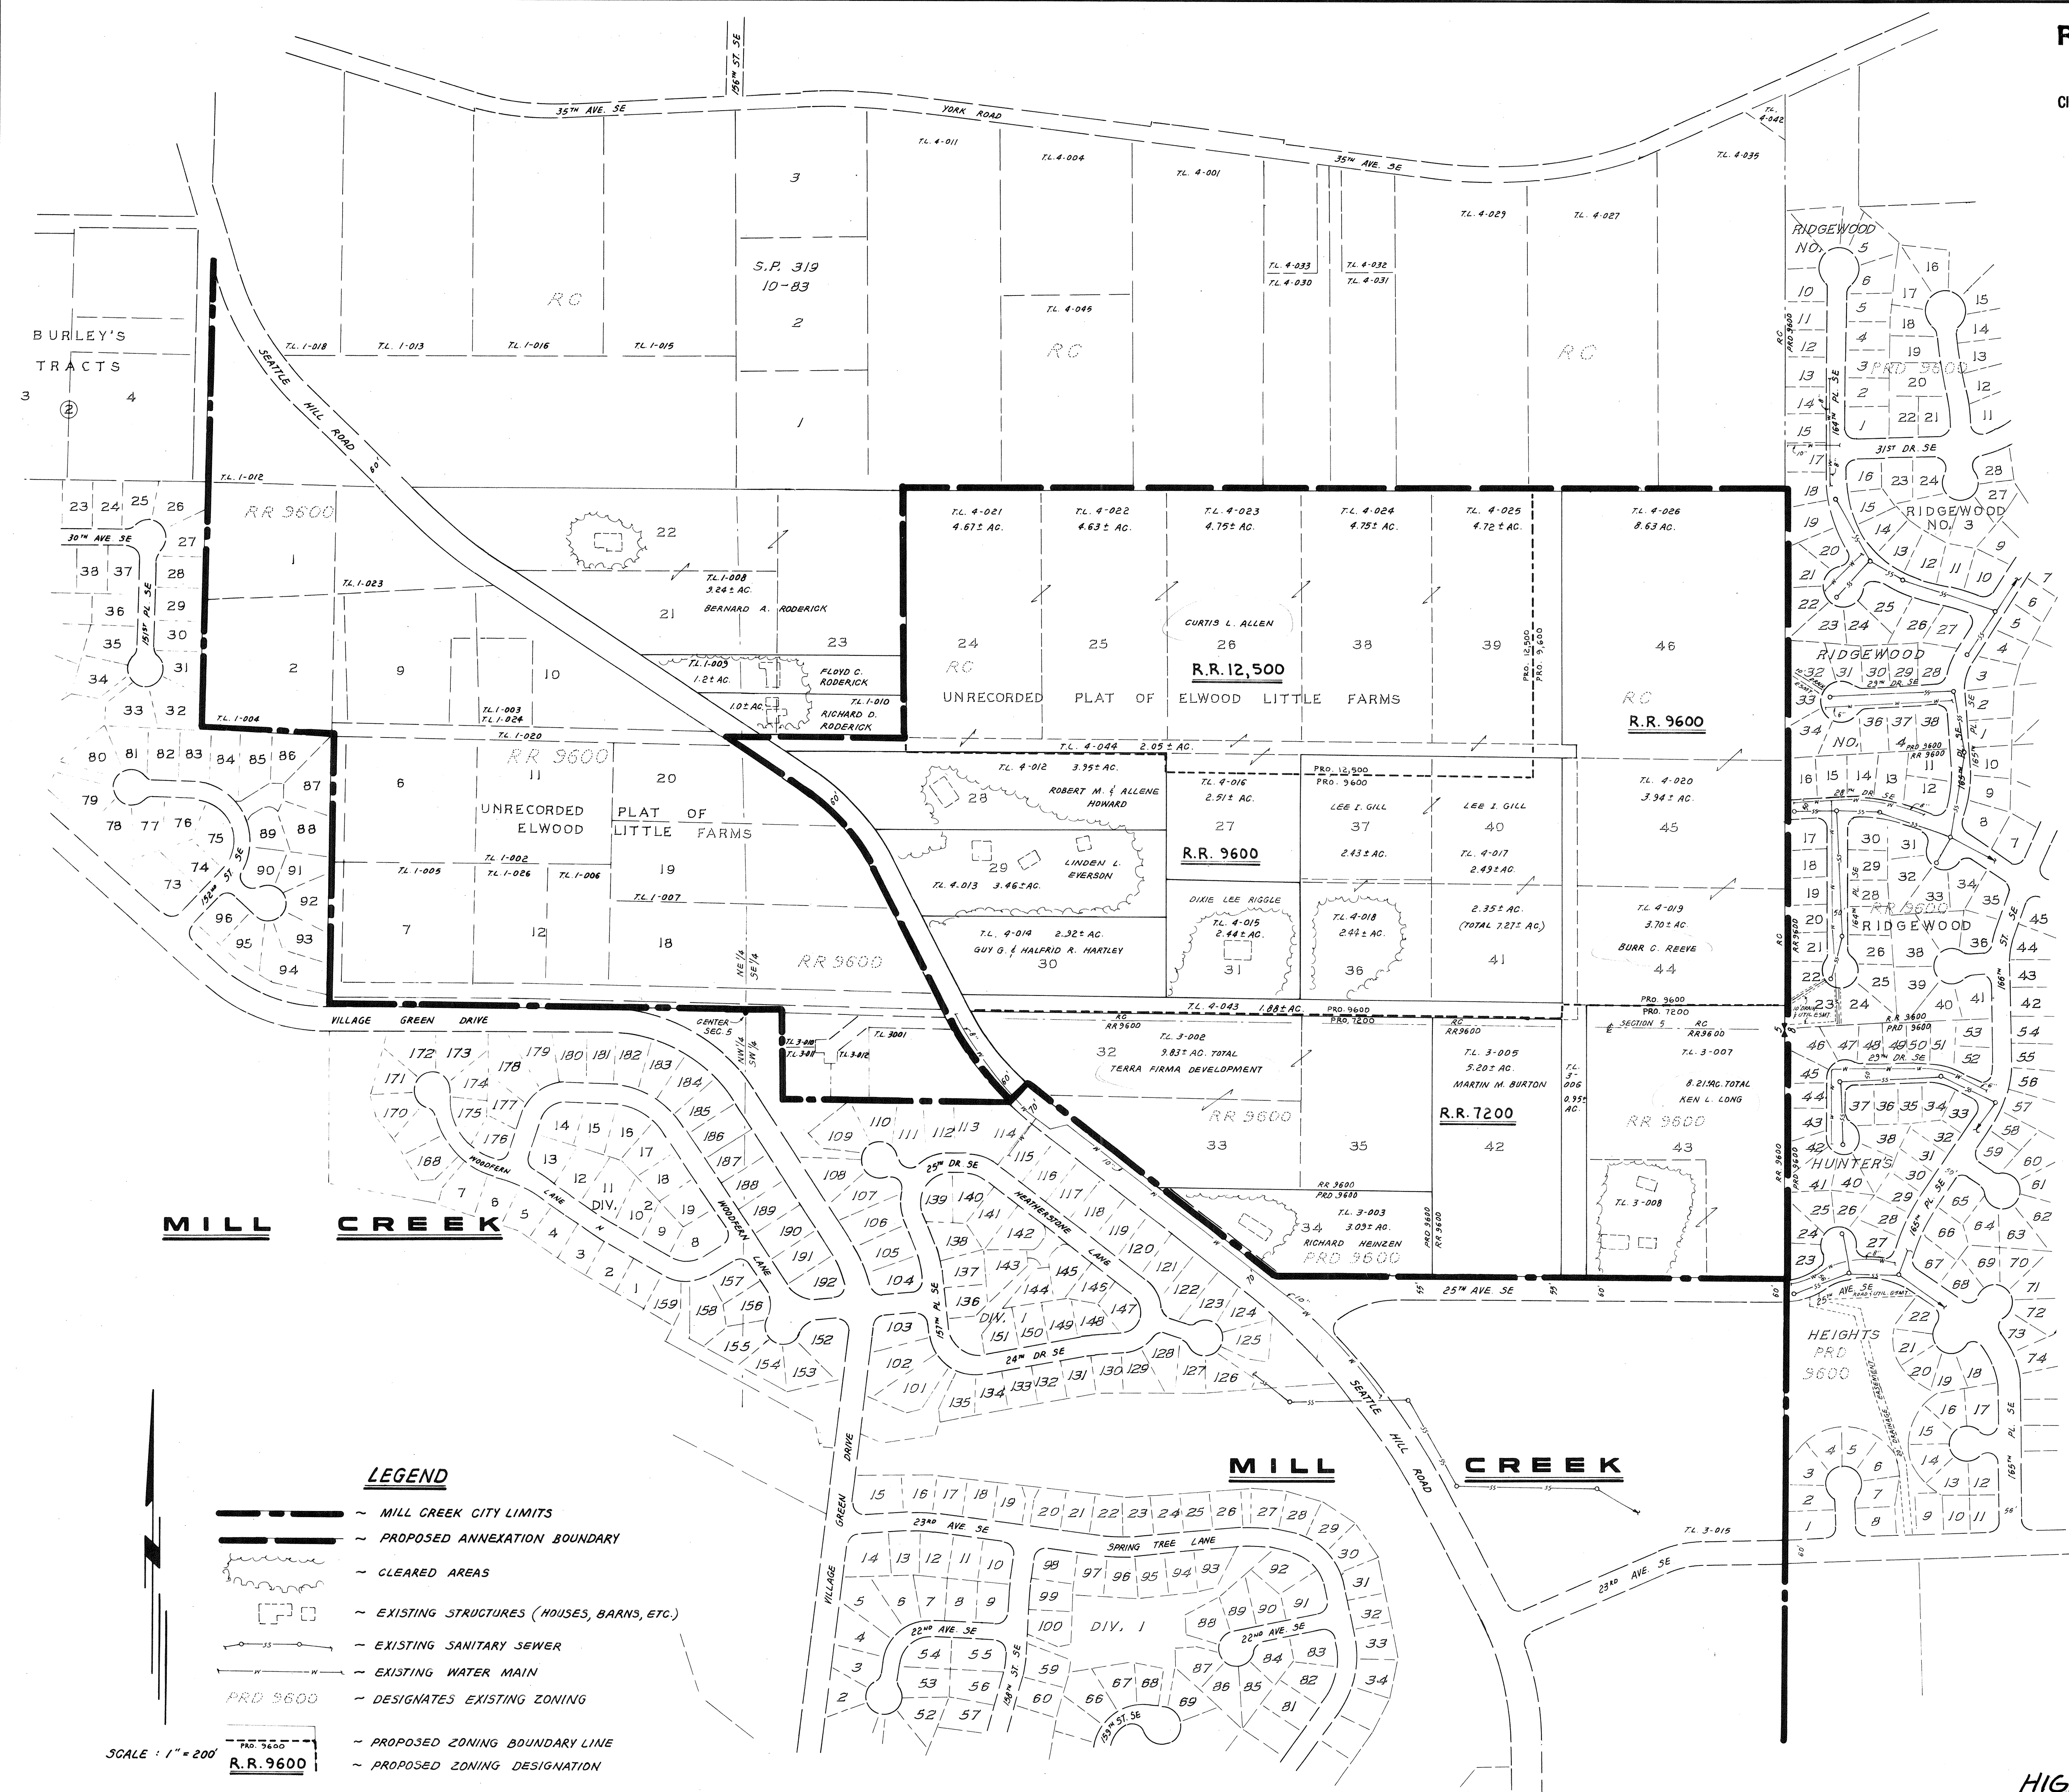


RECEIVED
OCT 18 1984
CITY OF MILL CREEK

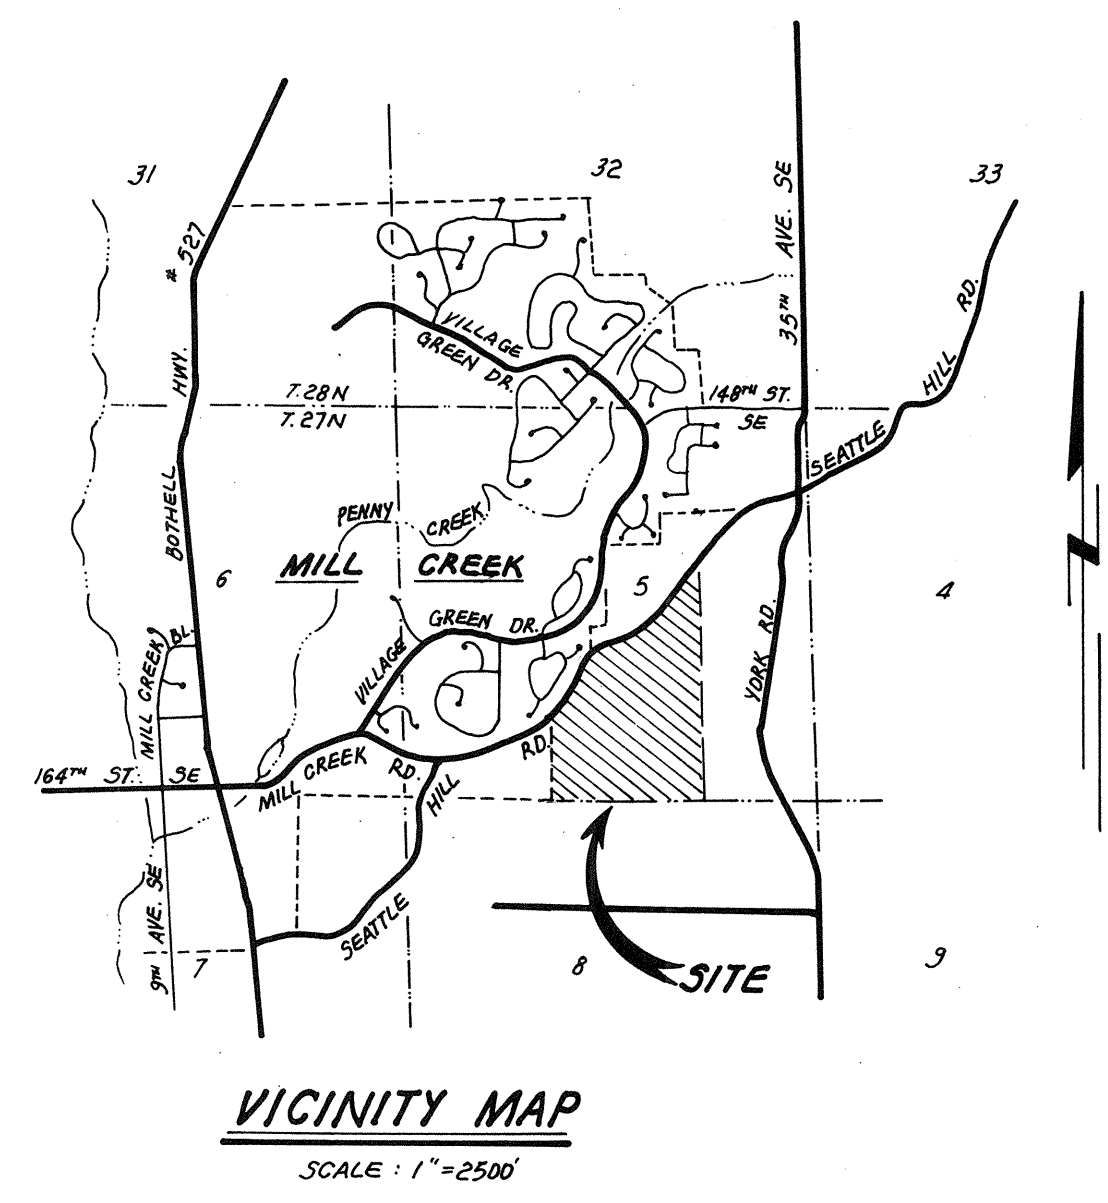

MILL CREEK

MILL CREEK

MILL CREEK SOUTH

- LEGEND**
- ~ MILL CREEK CITY LIMITS
 - ~ PROPOSED ANNEXATION BOUNDARY
 - ~ CLEARED AREAS
 - ~ EXISTING STRUCTURES (HOUSES, BARN, ETC.)
 - ~ EXISTING SANITARY SEWER
 - ~ EXISTING WATER MAIN
 - PRD 9600 ~ DESIGNATES EXISTING ZONING
 - ~ PROPOSED ZONING BOUNDARY LINE
 - ~ PROPOSED ZONING DESIGNATION

SCALE: 1" = 200'

PREPARED BY:





745-1594
OR
355-2776

LAND USE CONSULTANTS
CIVIL ENGINEERS • LAND SURVEYORS
13322 Highway 99 South • Everett, WA 98204

HIGHLANDS

FOXGLOVE AT MILL CREEK

CITY OF MILL CREEK, WASHINGTON

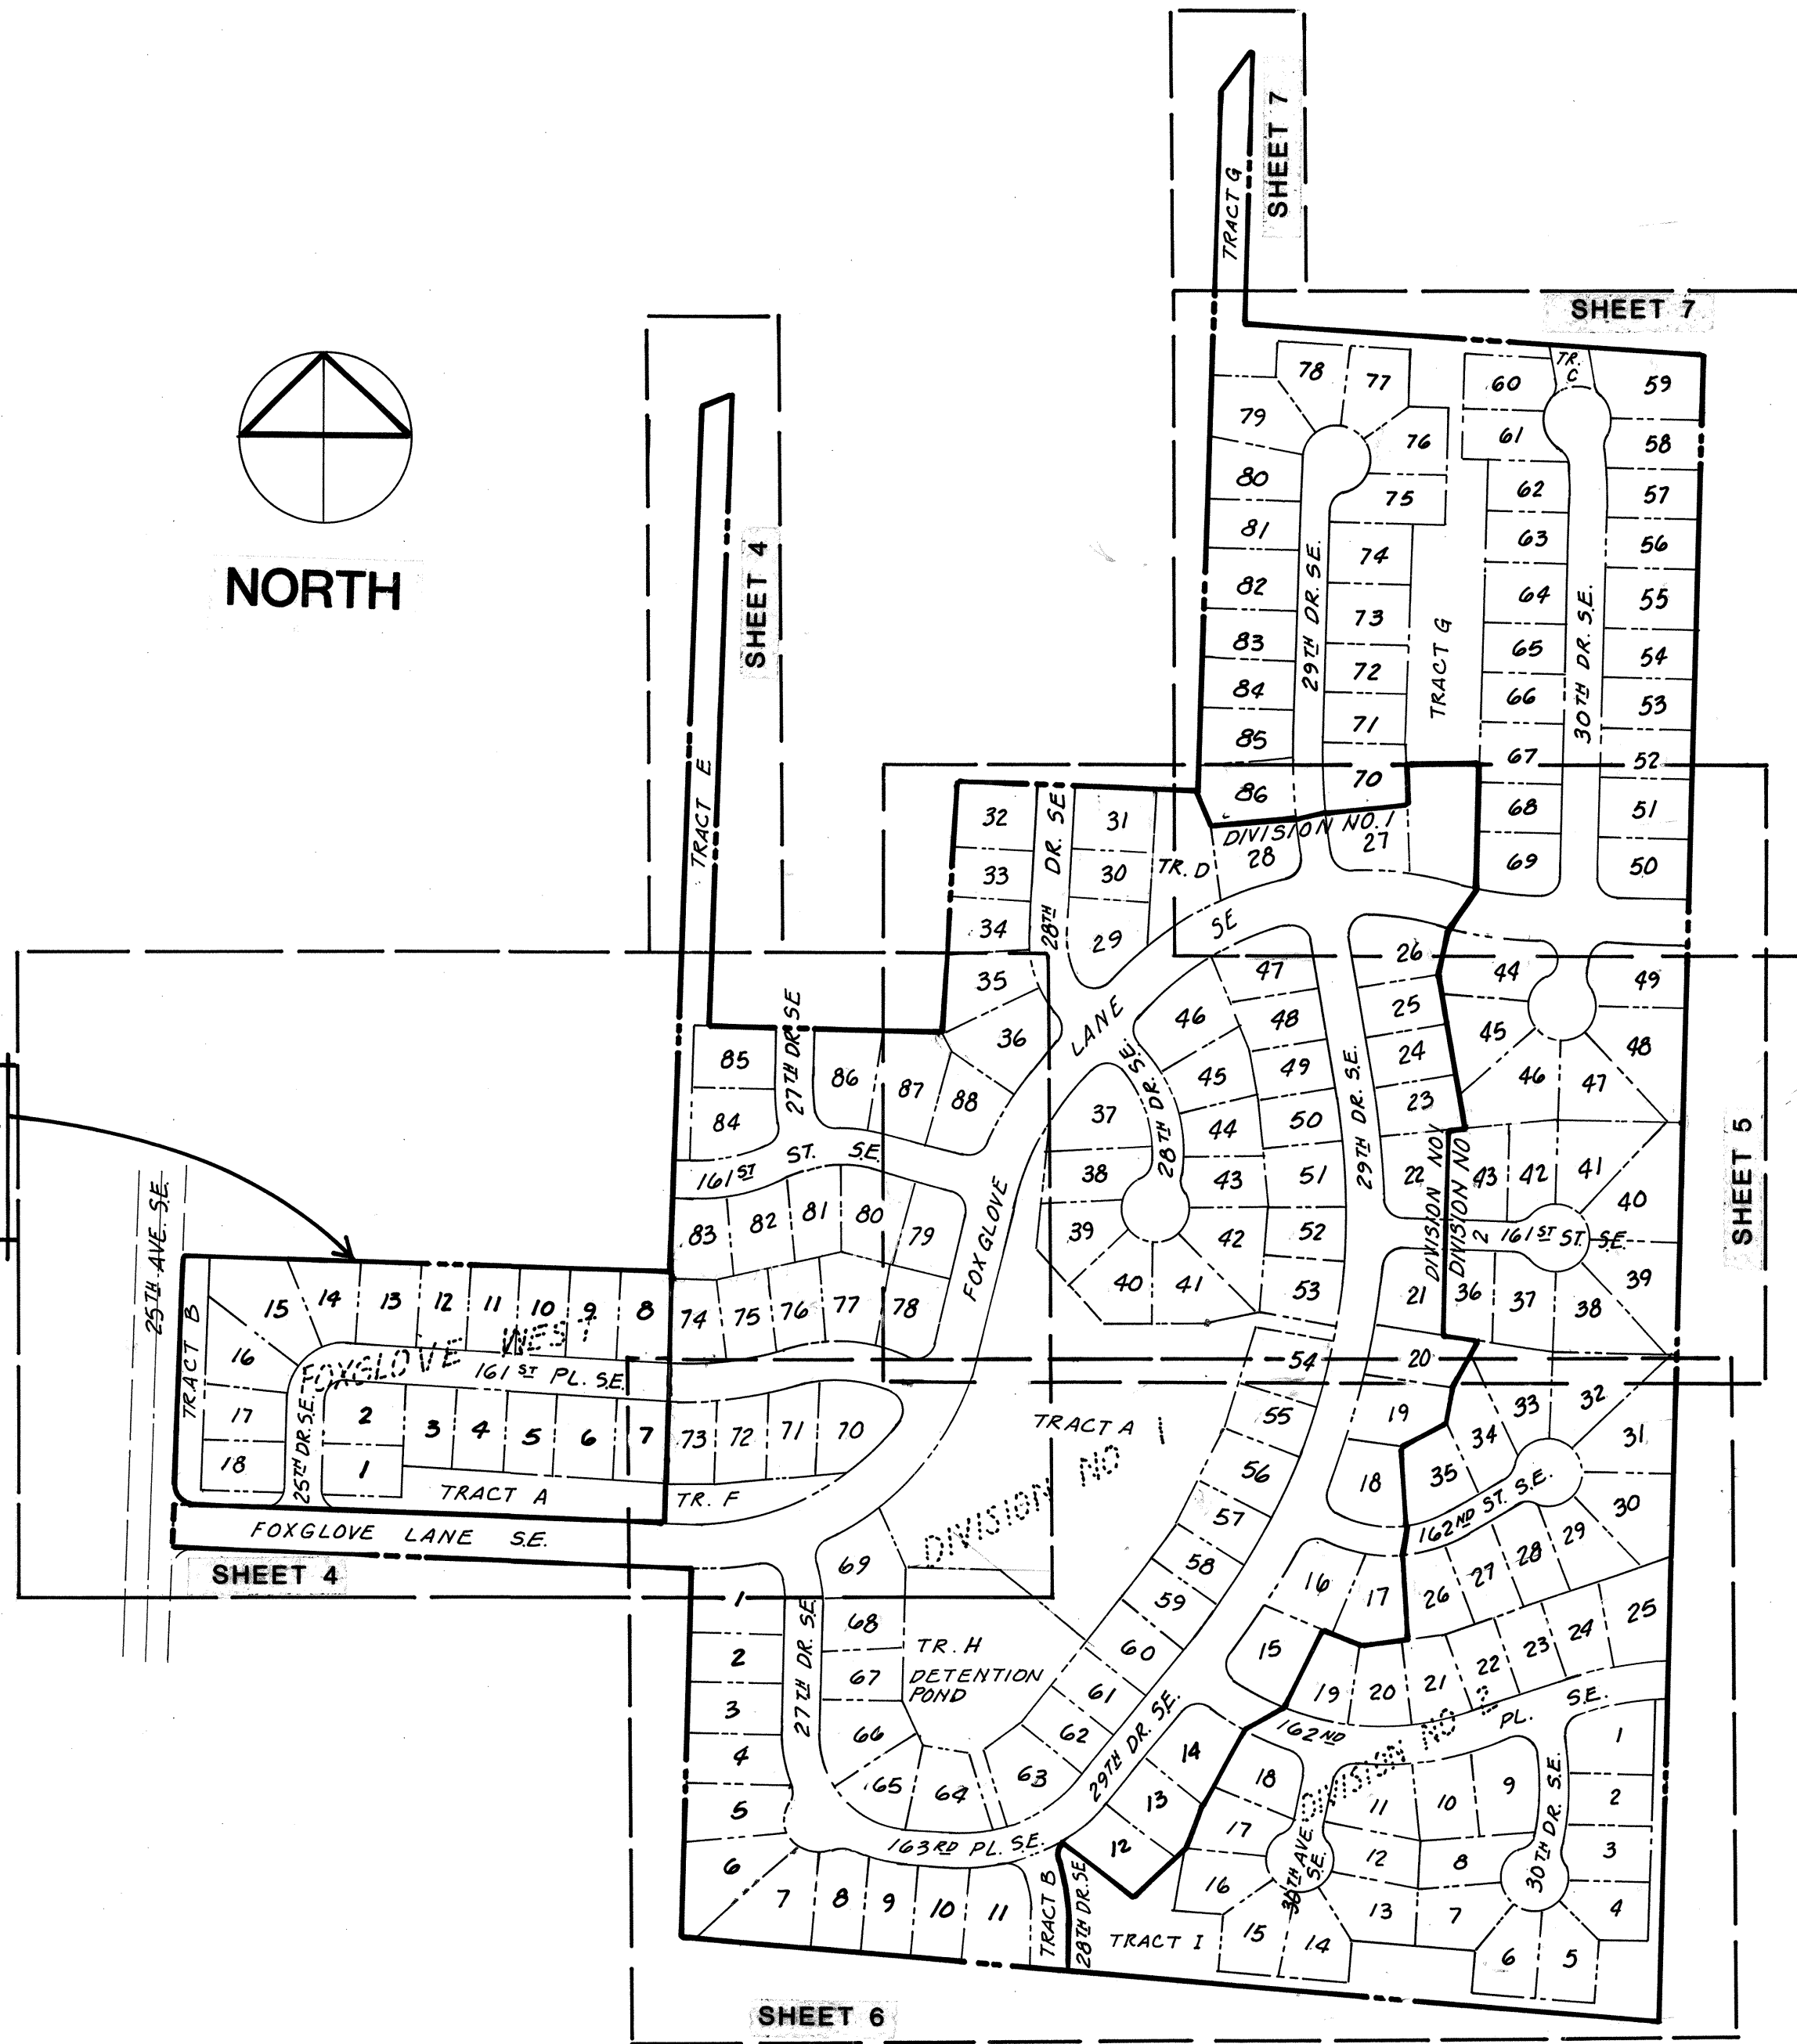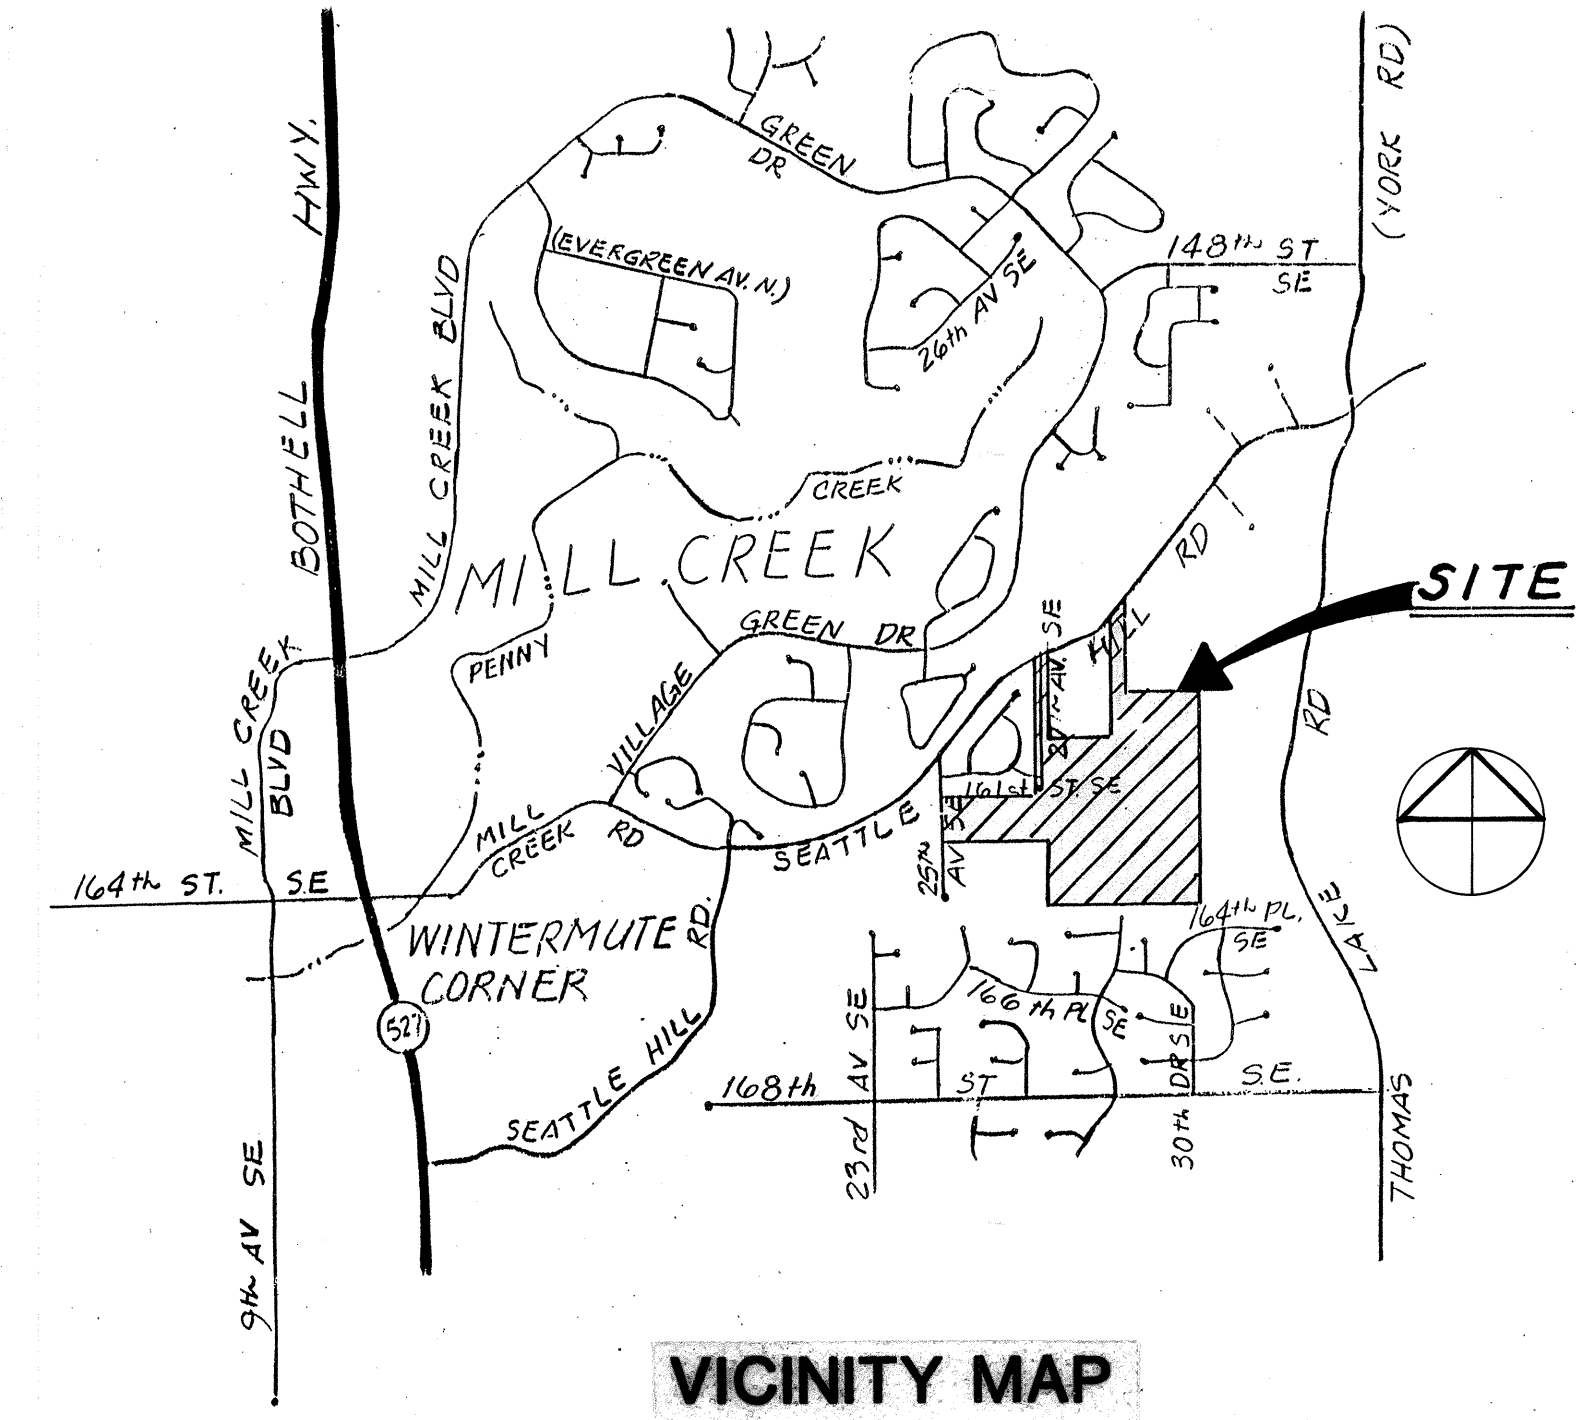

APPROVED BY THE CITY OF MILL CREEK 5-31-88 BY ALLEN NEWBELL FOR "FOXGLOVE WEST AND A PORTION OF FOXGLOVE LANE S.E." IMMEDIATELY ADJACENT TO THE PLAT OF FOXGLOVE WEST.

SHEET INDEX

DESCRIPTION	SHEET NO.
--KEY MAP	1
--TEMPORARY EROSION/SEDIMENTATION CONTROL PLAN	2
--TEMPORARY SILTATION POND AND DETAILS	2A
--STREET AND STORM DRAINAGE DETAILS	3
--STREET AND STORM DRAINAGE PLAN	4
--STREET AND STORM DRAINAGE PLAN	5
--STREET AND STORM DRAINAGE PLAN	6
--STREET AND STORM DRAINAGE PLAN	7
--STREET AND STORM DRAINAGE PROFILES	8
--STREET AND STORM DRAINAGE PROFILES	9
--STREET AND STORM DRAINAGE PROFILES	10
--STREET AND STORM DRAINAGE PROFILES	11
--STREET AND STORM DRAINAGE PROFILES	12
--STREET AND STORM DRAINAGE PROFILES	13

J. Allan Newbill
 APPROVED BY THE CITY OF MILL CREEK DATE 8-15-88

HIGHLANDS



FOXGLOVE AT MILL CREEK
 PACIFIC PROPERTIES, INC.
 MILL CREEK, WASHINGTON



deen
 DAVID EVANS AND ASSOCIATES, INC.
 501 18TH AVE. S.E. BELLEVUE, WA 98004 206/465-5871


1 4 19 88 REVISED LOT NUMBERS & TRACTS
 REVISIONS

1 OF THIRTEEN SHEETS
 DRAWN J.B.
 DATE 3-7-88
 FILE ENVW 024
 CHECKED M.K.H.

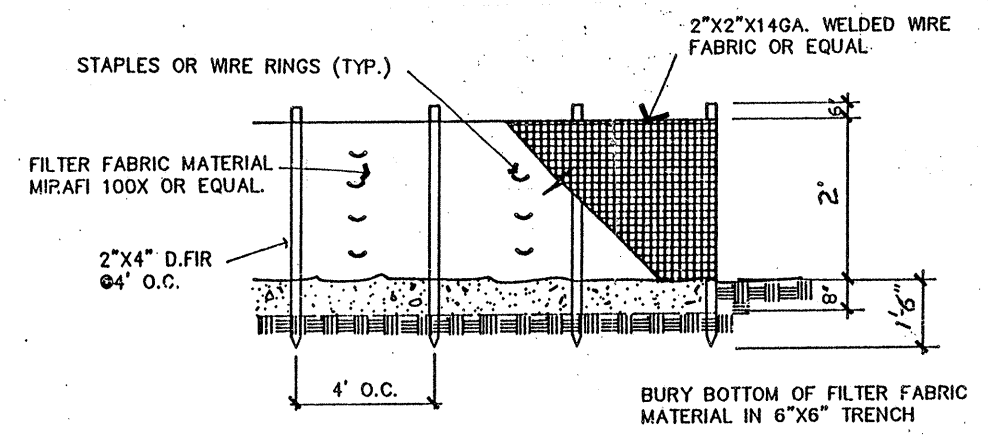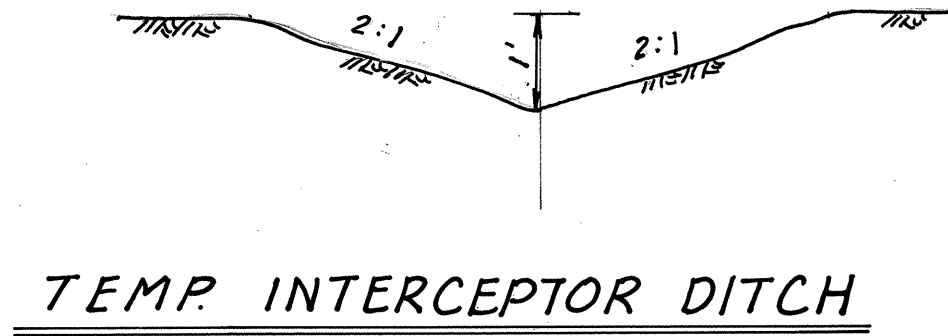

NOTES


1. PLACE 1" OF 3/4" TO 1 1/2" WASHED ROCK OR PEA GRAVEL ON BOTH SIDES OF FENCE TO CREATE A BEVEL SHAPE.
2. FABRIC SHALL COVER BOTTOM OF 6"x6" TRENCH AND EXTEND BEYOND THE LIMITS OF THE GRAVEL IN ORDER TO MAINTAIN AN EXCESS OVERLAY OF 2" MIN. AS SHOWN IN THE TYP. CROSS-SECTION.

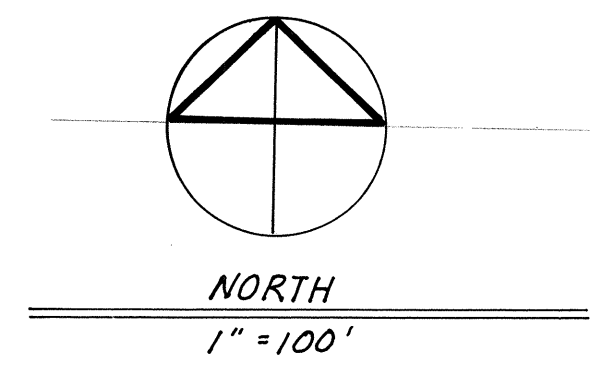

TESCP NOTES:

1. WHERE POSSIBLE, MAINTAIN NATURAL VEGETATION FOR SILT CONTROL.
2. AS CONSTRUCTION PROGRESSES AND SEASONAL CONDITIONS DICTATE, MORE SILTATION CONTROL FACILITIES MAY BE REQUIRED TO ENSURE COMPLETE SILTATION CONTROL. THEREFORE, DURING THE COURSE OF CONSTRUCTION, IT SHALL BE THE OBLIGATION AND RESPONSIBILITY OF THE DEVELOPER TO ADDRESS ANY NEW CONDITIONS THAT MAY BE CREATED BY HIS ACTIVITIES AND TO PROVIDE ADDITIONAL FACILITIES OVER AND ABOVE THE MINIMUM REQUIREMENTS AS MAY BE NEEDED.
3. ALL TEMPORARY SILTATION CONTROLS SHALL BE MAINTAINED IN A SATISFACTORY CONDITION UNTIL SUCH TIME THAT CLEARING AND/OR CONSTRUCTION IS COMPLETED, PERMANENT DRAINAGE FACILITIES ARE OPERATIONAL AND THE POTENTIAL FOR EROSION HAS PASSED.
4. AFTER CONSTRUCTION, TEMPORARY EROSION CONTROL AREAS SHOULD BE RETURNED TO ORIGINAL GROUND CONDITIONS.
5. VEGETATION SHALL BE ESTABLISHED ON AREAS DISTURBED OR ON AREAS OF CONSTRUCTION AS NECESSARY TO MINIMIZE EROSION.
6. TEMPORARY SILT FENCES MAY BE REQUIRED AROUND CATCH BASINS DURING CONSTRUCTION, ADDITIONAL SILT FENCES MAY BE NEEDED AS WEATHER CONDITIONS CHANGE.
7. ADDITIONAL SILT FENCES AND STRAW BALES SHOULD BE STOCKPILED AND AVAILABLE ON SITE FOR IMMEDIATE USE. THE CITY ENGINEER MAY REQUEST ADDITIONAL EROSION PROTECTION MEASURES AS CONDITIONS DICTATE.

~~~~~ TYPICAL CLEARING LIMITS R/W +10' (TYP)  
SEE PLAN SHEETS 4 THRU 7 AND PARK PLAN FOR ADDITIONAL CLEARING AS REQ'D

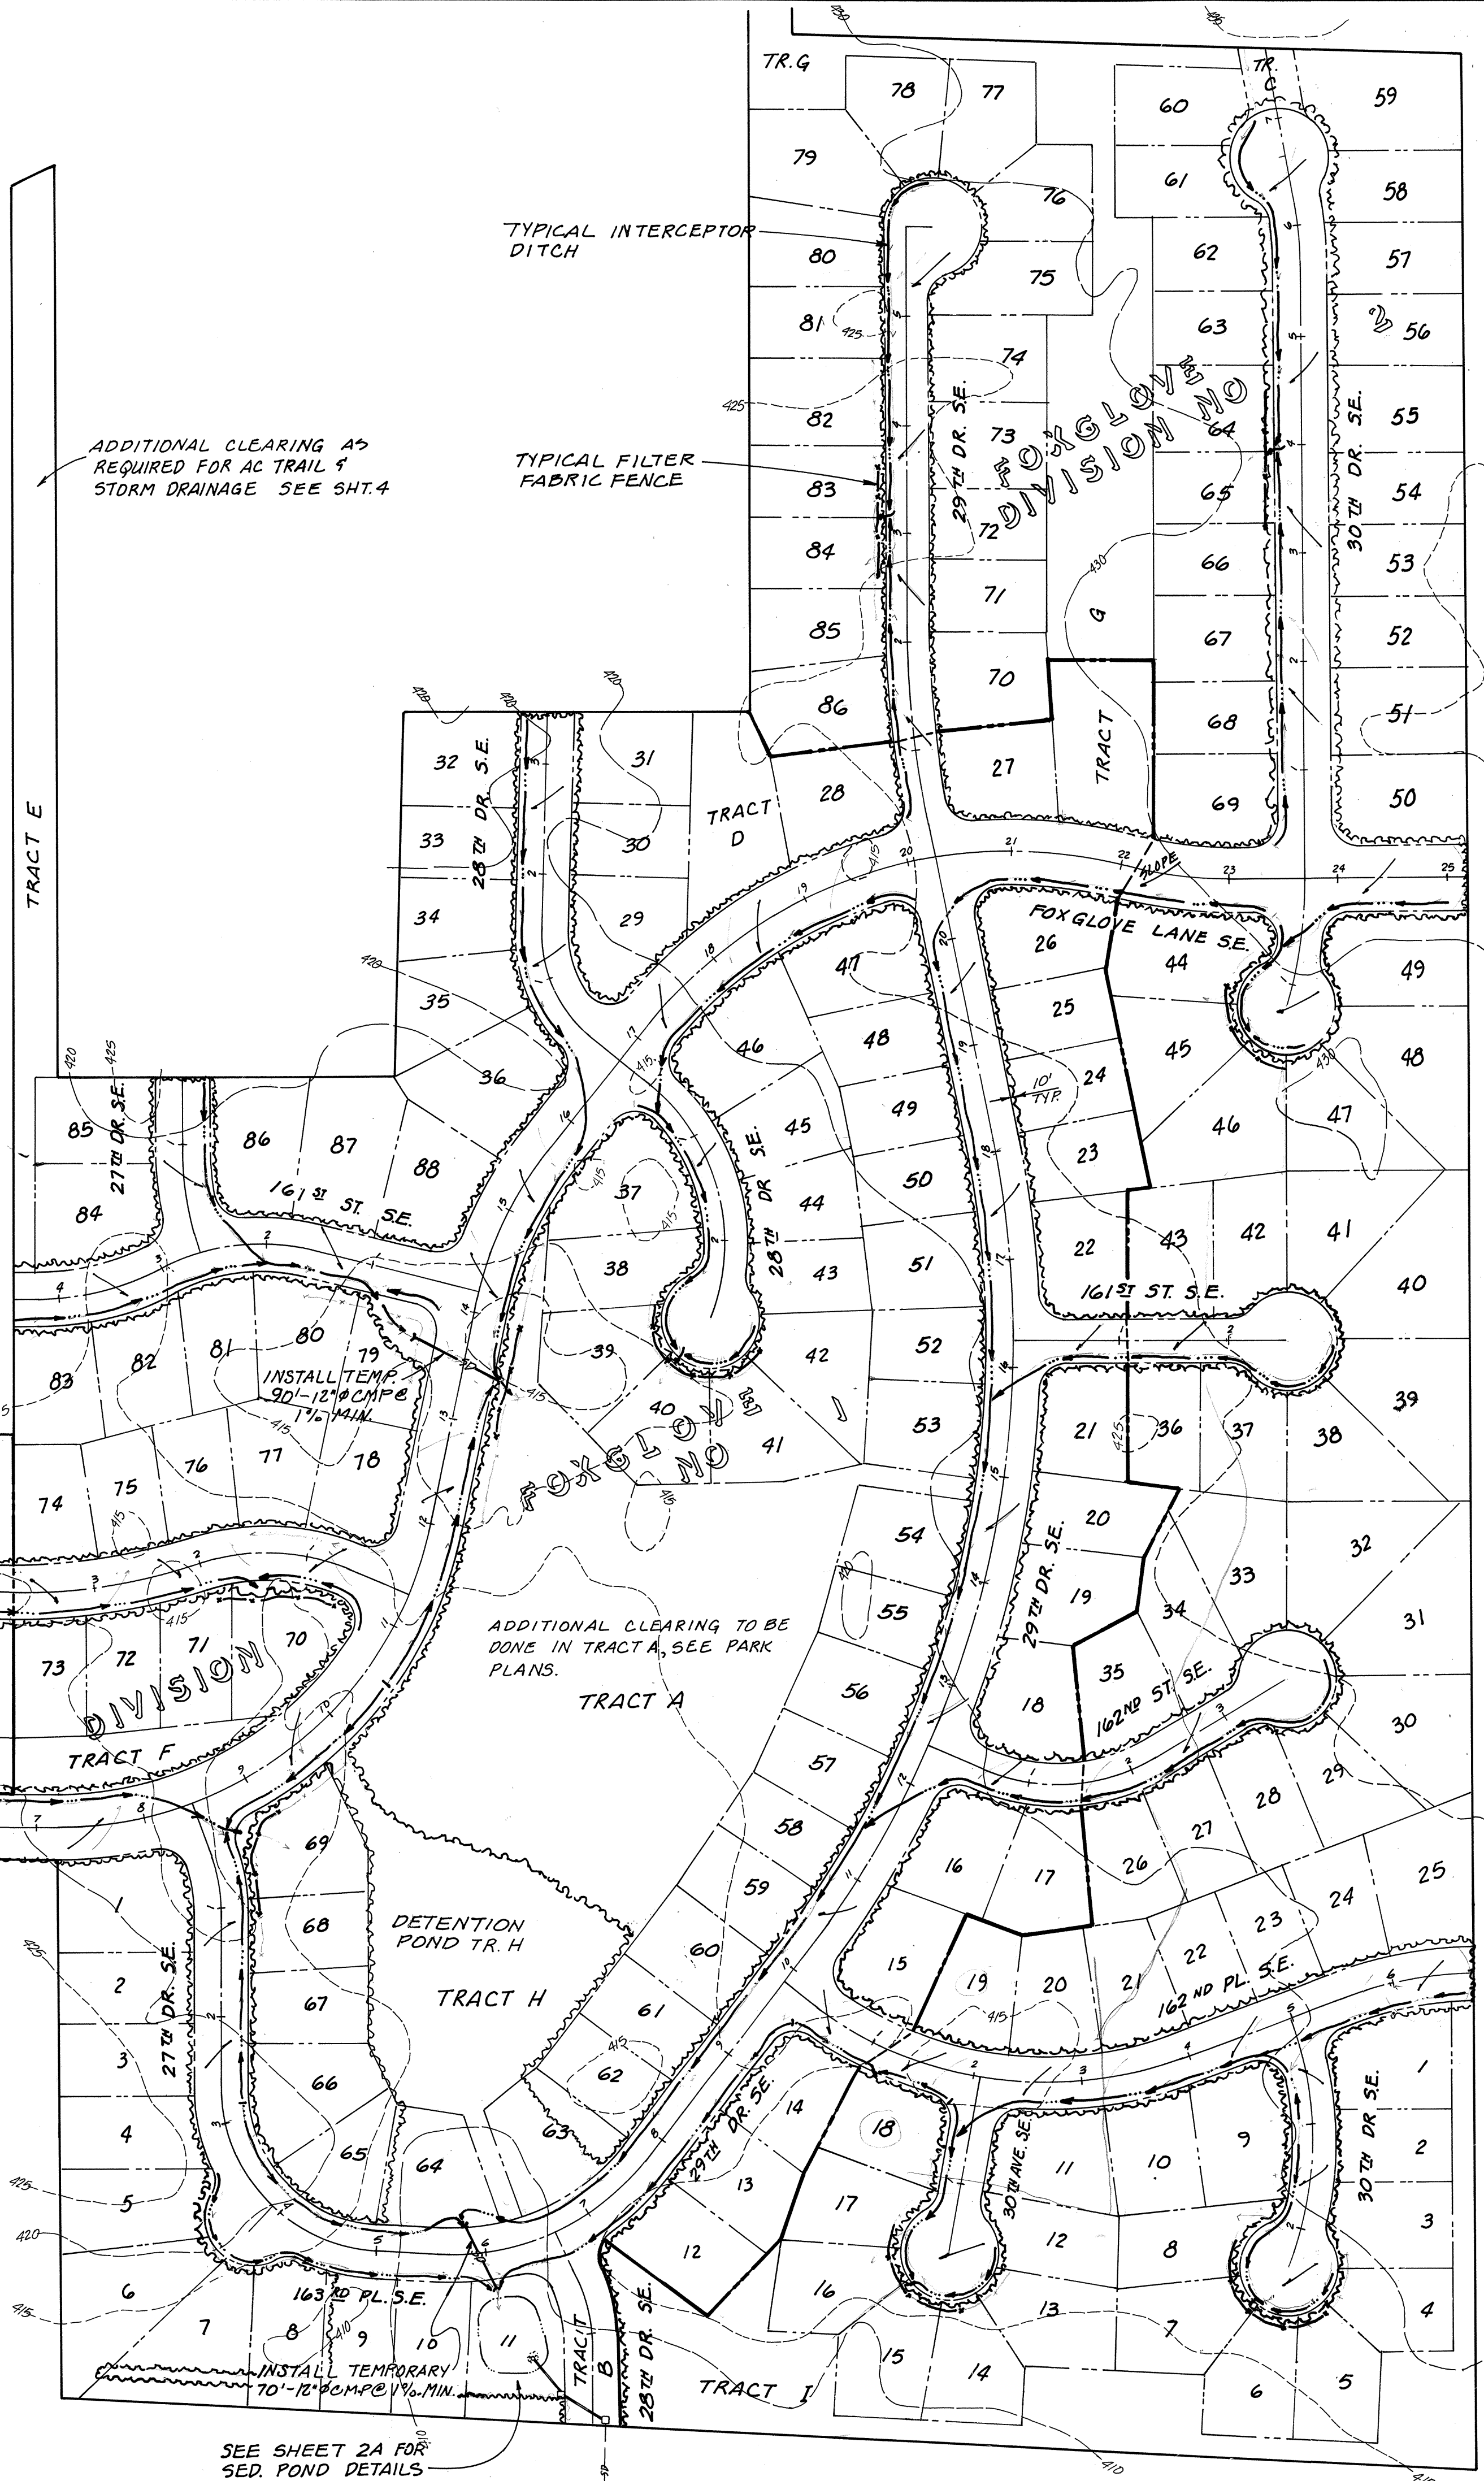

TEMPORARY GRAVEL ENTRANCE

PROTECT ALL STORM DRAINAGE IN 25th AVE. SE. FROM SILTATION.

NOTE: TEMP. SED. POND IN LOT 11 IS TEMPORARY ONLY AND WILL BE FILLED IN AT THE COMPLETION OF THE STORM DRAINAGE SYSTEM.

SEE SHEET 2A FOR SED. POND DETAILS

HIGHLANDS

J. Allan Newhill 8-15-88  
APPROVED BY THE CITY OF MILL CREEK DATE


TEMPORARY EROSION/  
SEDIMENTATION  
CONTROL PLAN

FOXGLOVE AT MILL CREEK  
PACIFIC PROPERTIES, INC.  
MILL CREEK, WASHINGTON




David Evans and Associates, Inc.  
301 10th Ave. S.E. Bellevue, WA 98004-2004/408-8571

|                              |                    |
|------------------------------|--------------------|
| 2                            | OF THIRTEEN SHEETS |
| SCALE                        | 1" = 100'          |
| DATE                         | 3-7-88             |
| FILE                         | ENVH 024           |
| DESIGN                       | J.B.               |
| DRAWN                        | J.B.               |
| CHECKED                      | M.K.H.             |
| DATE                         | 4-19-88            |
| ADDED DIVISIONS & LOT NO. W/ |                    |
| ADDITIONAL CLEARING NOTES    |                    |

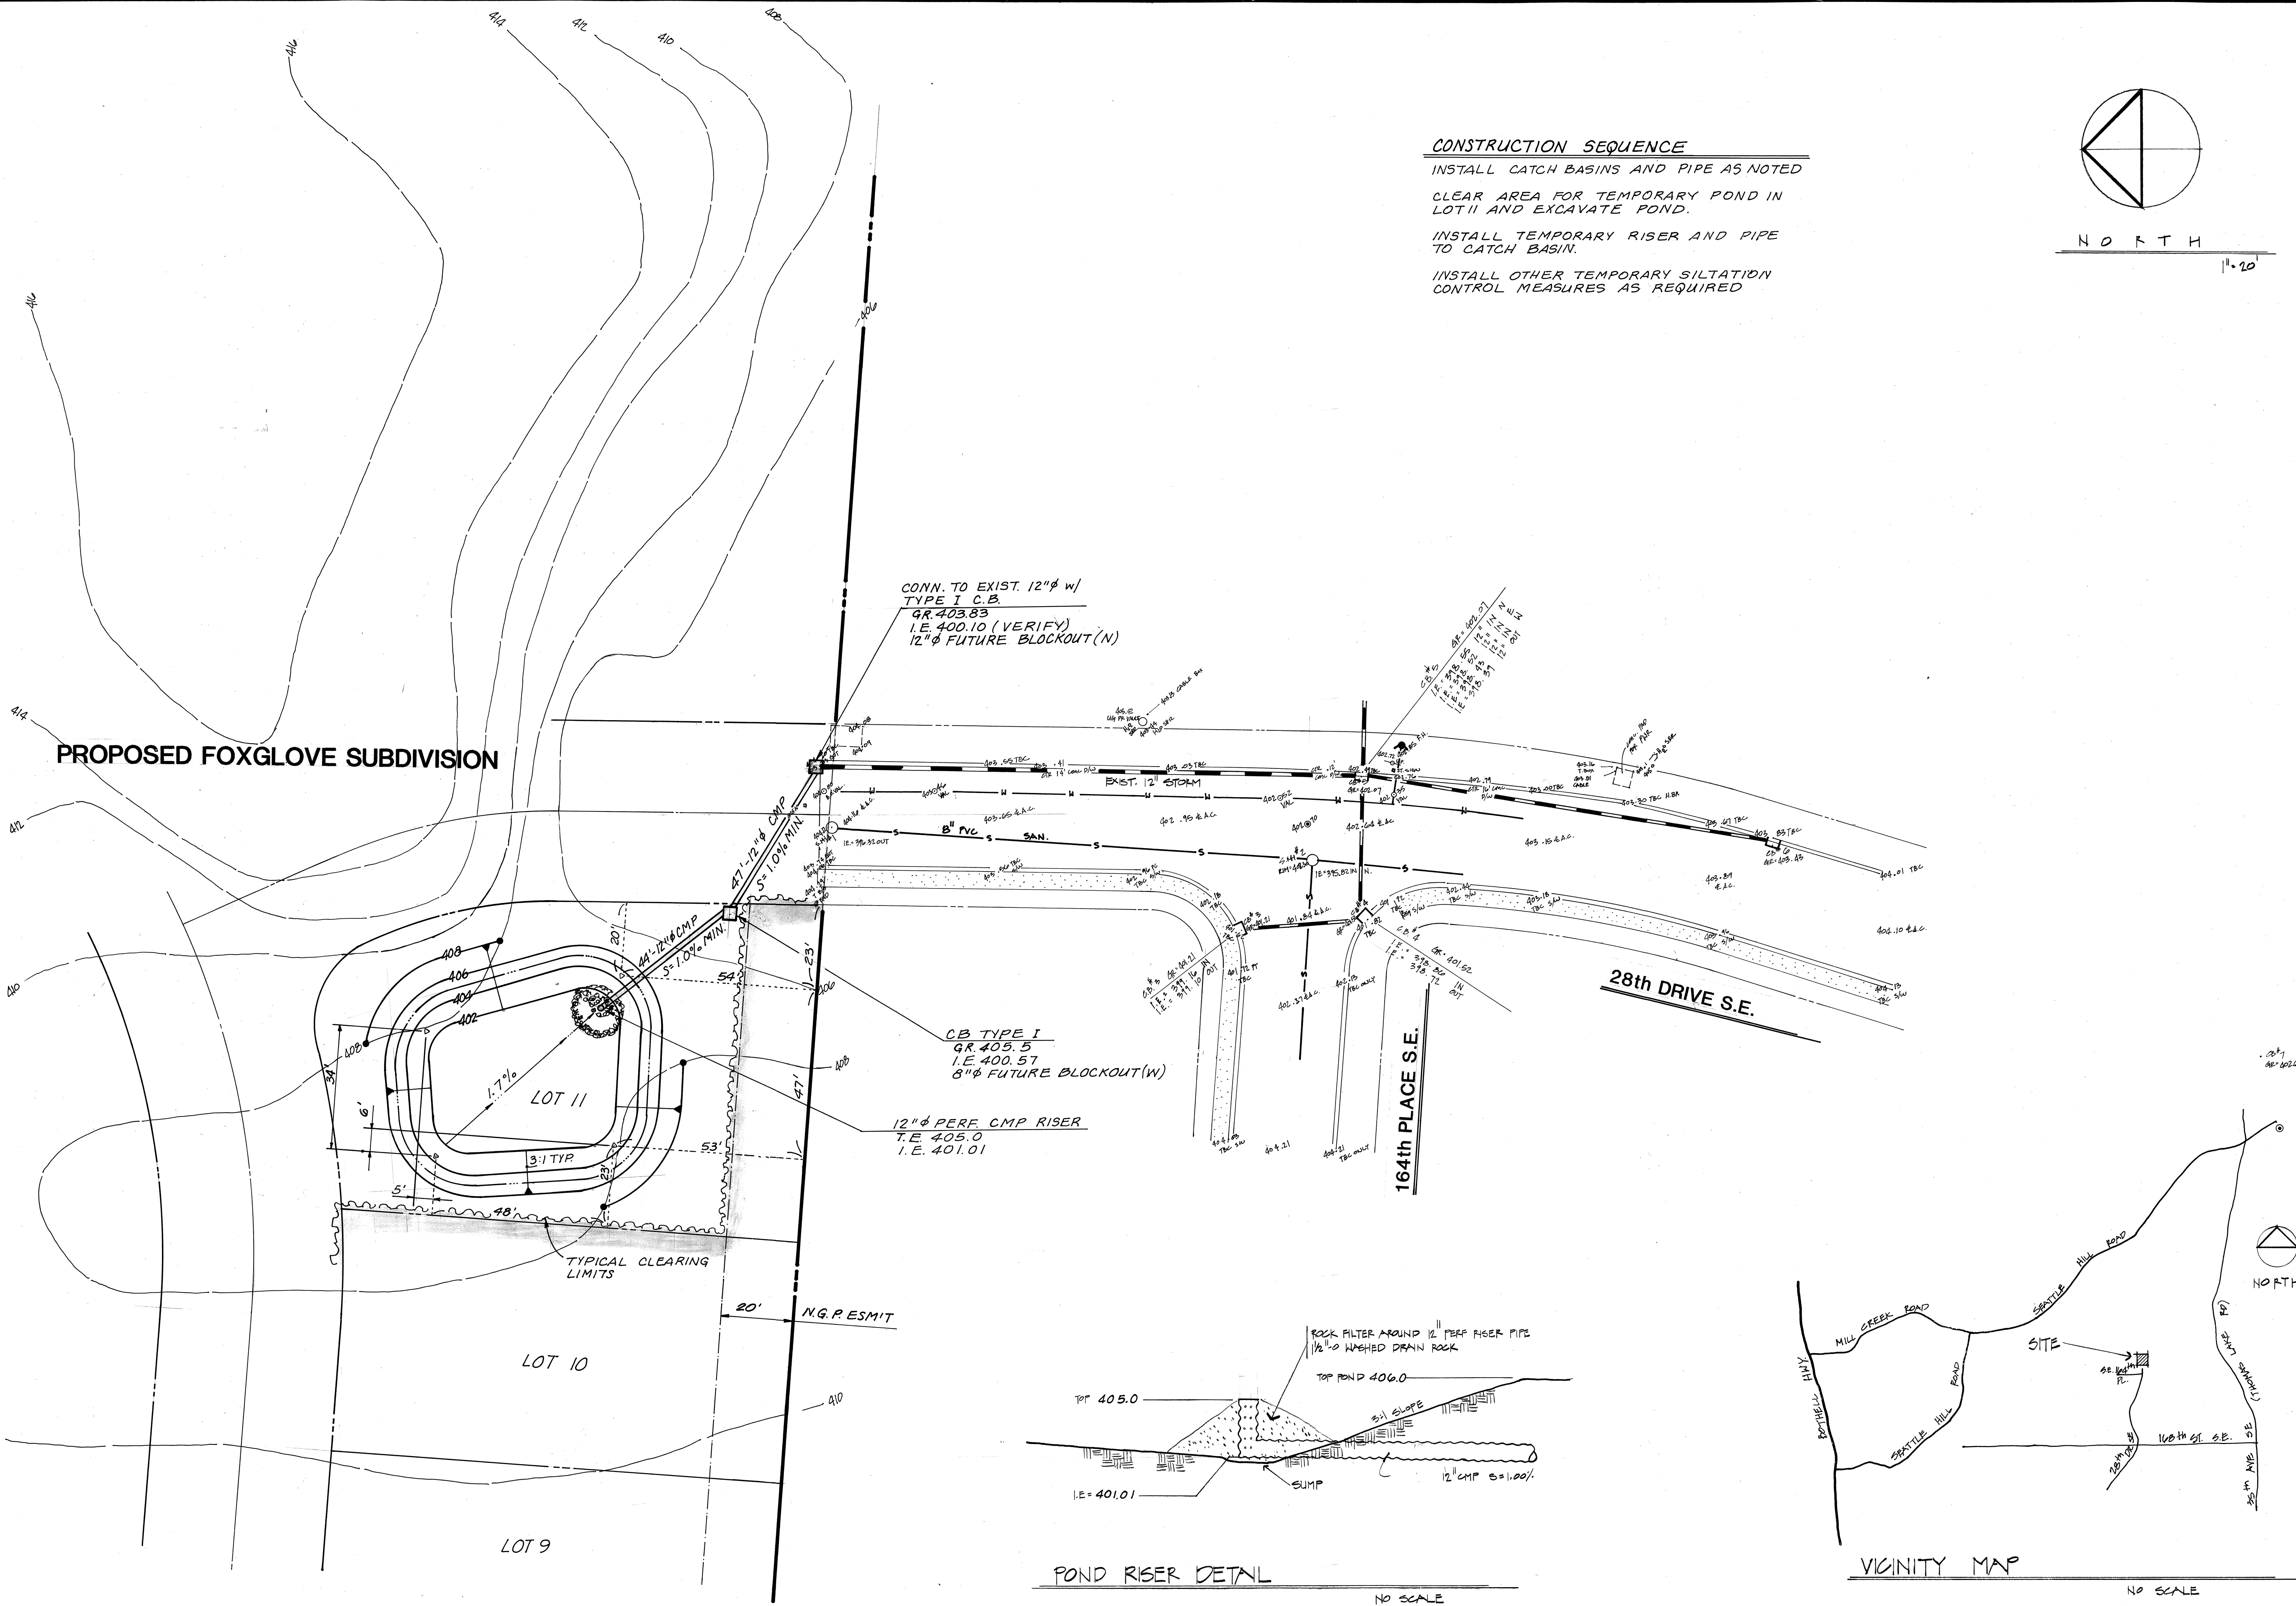

**CONSTRUCTION SEQUENCE**  
 INSTALL CATCH BASINS AND PIPE AS NOTED  
 CLEAR AREA FOR TEMPORARY POND IN LOT 11 AND EXCAVATE POND.  
 INSTALL TEMPORARY RISER AND PIPE TO CATCH BASIN.  
 INSTALL OTHER TEMPORARY SILTATION CONTROL MEASURES AS REQUIRED

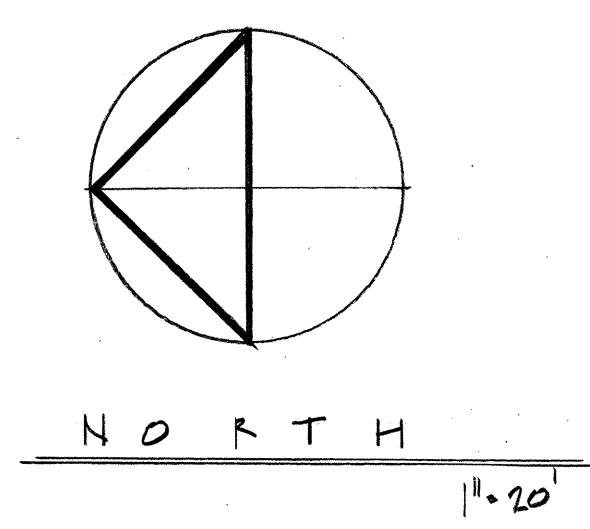


CONN. TO EXIST. 12"  $\phi$  w/  
 TYPE I C.B.  
 GR. 403.83  
 I.E. 400.10 (VERIFY)  
 12"  $\phi$  FUTURE BLOCKOUT(N)

CB TYPE I  
 GR. 405.5  
 I.E. 400.57  
 8"  $\phi$  FUTURE BLOCKOUT(W)

12"  $\phi$  PERF CMP RISER  
 T.E. 405.0  
 I.E. 401.01


164th PLACE S.E.

28th DRIVE S.E.

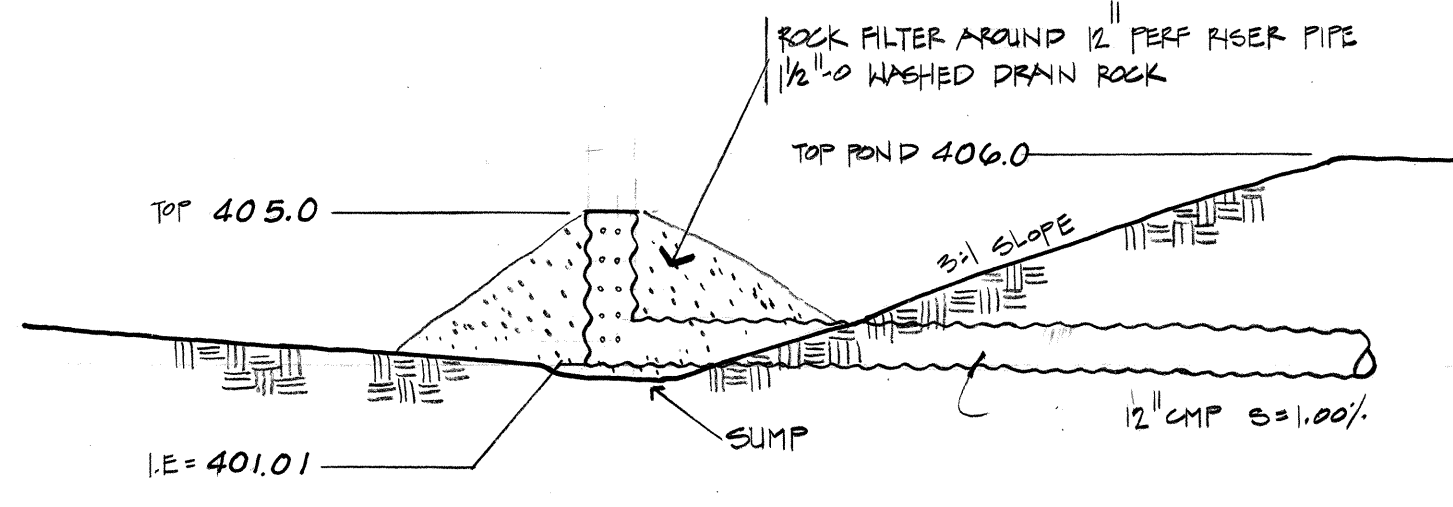

POND RISER DETAIL

NO SCALE

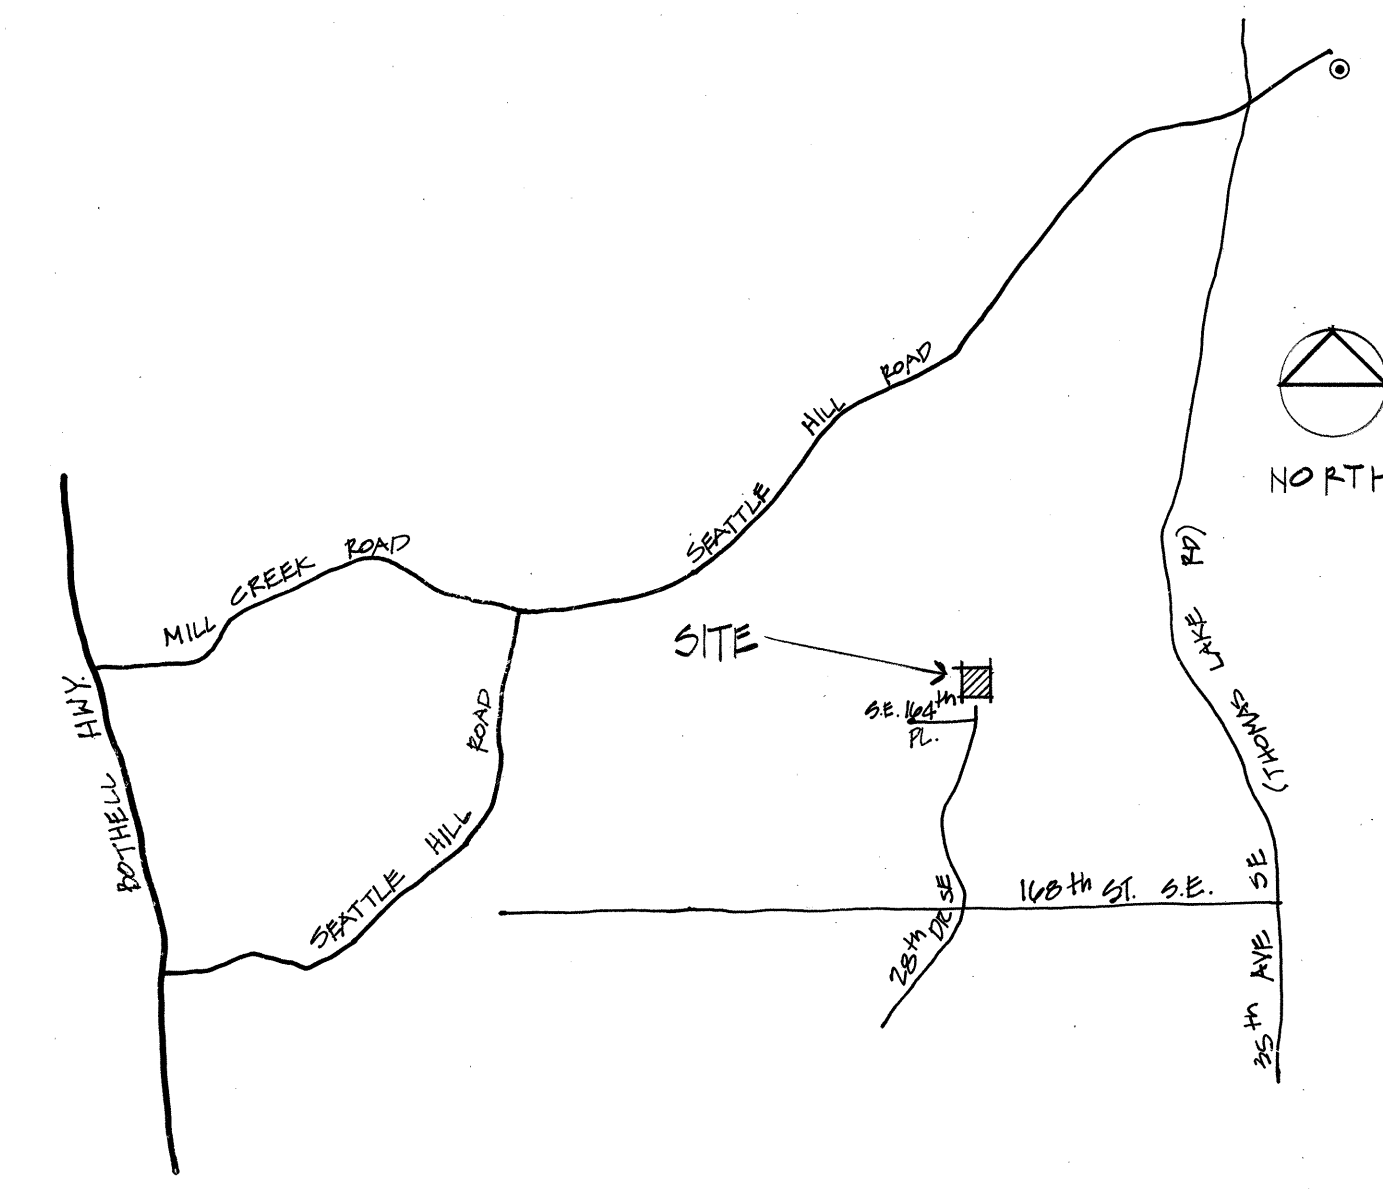

VICINITY MAP

NO SCALE

HIGHLANDS





**deen**  
 DAVID EVANS AND ASSOCIATES, INC.  
 301 100TH AVE S.E. BELLEVUE, WA 98004 206/468-3071

**TEMPORARY SILTATION POND  
 FOR PROPOSED FOXGLOVE SUBDIVISION**  
 MILL CREEK, WASHINGTON





|      |           |          |                                 |
|------|-----------|----------|---------------------------------|
| 2A   | ONE       | THIRTEEN | SHEETS                          |
| DATE | NOV. 1987 | OF       | ONE                             |
| REV. | ENR-1024  | DESIGN   | DATE                            |
|      |           | DRAWN    | 1/15/88                         |
|      |           | CHECKED  | EPB                             |
|      |           |          | REVISIONS                       |
|      |           |          | 1-15-88 RELOC. TEMP. SILT. POND |



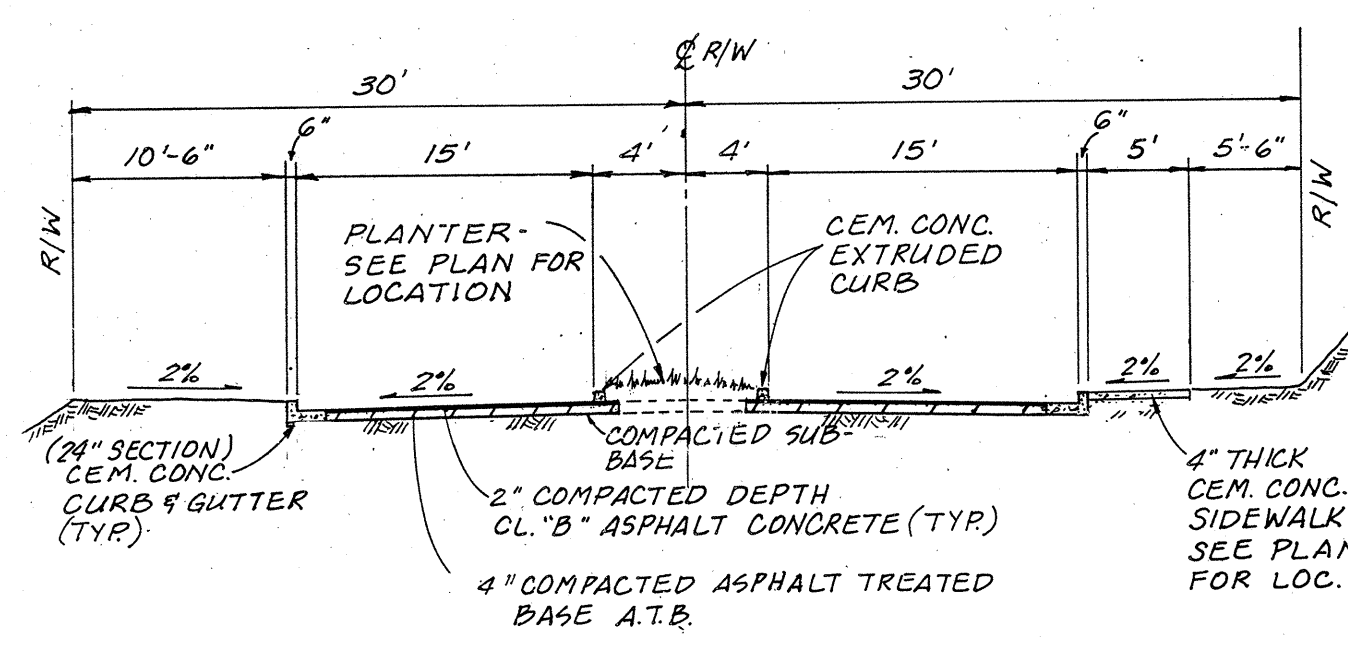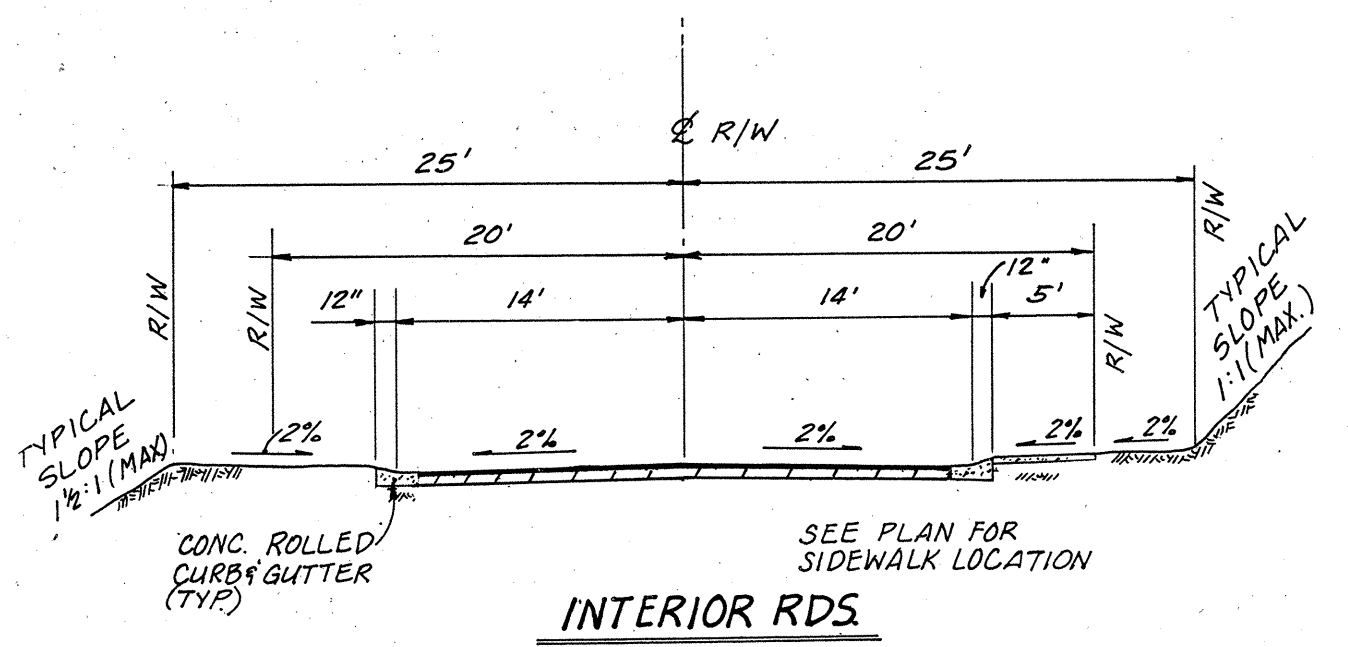


**ALTR. PAV'T SECTION: FOXGLOVE LANE SE.**  
2" COMP. DEPTH CL. B'S A.C.P. OVER 2" COMP. DEPTH C.S.T.C. OVER 4" COMP. DEPTH C.S.B.C. OVER COMP. SUB-BASE.


**TYPICAL PAV'T SECT.**  
STA. 0+00.00 TO STA. 8+45.87

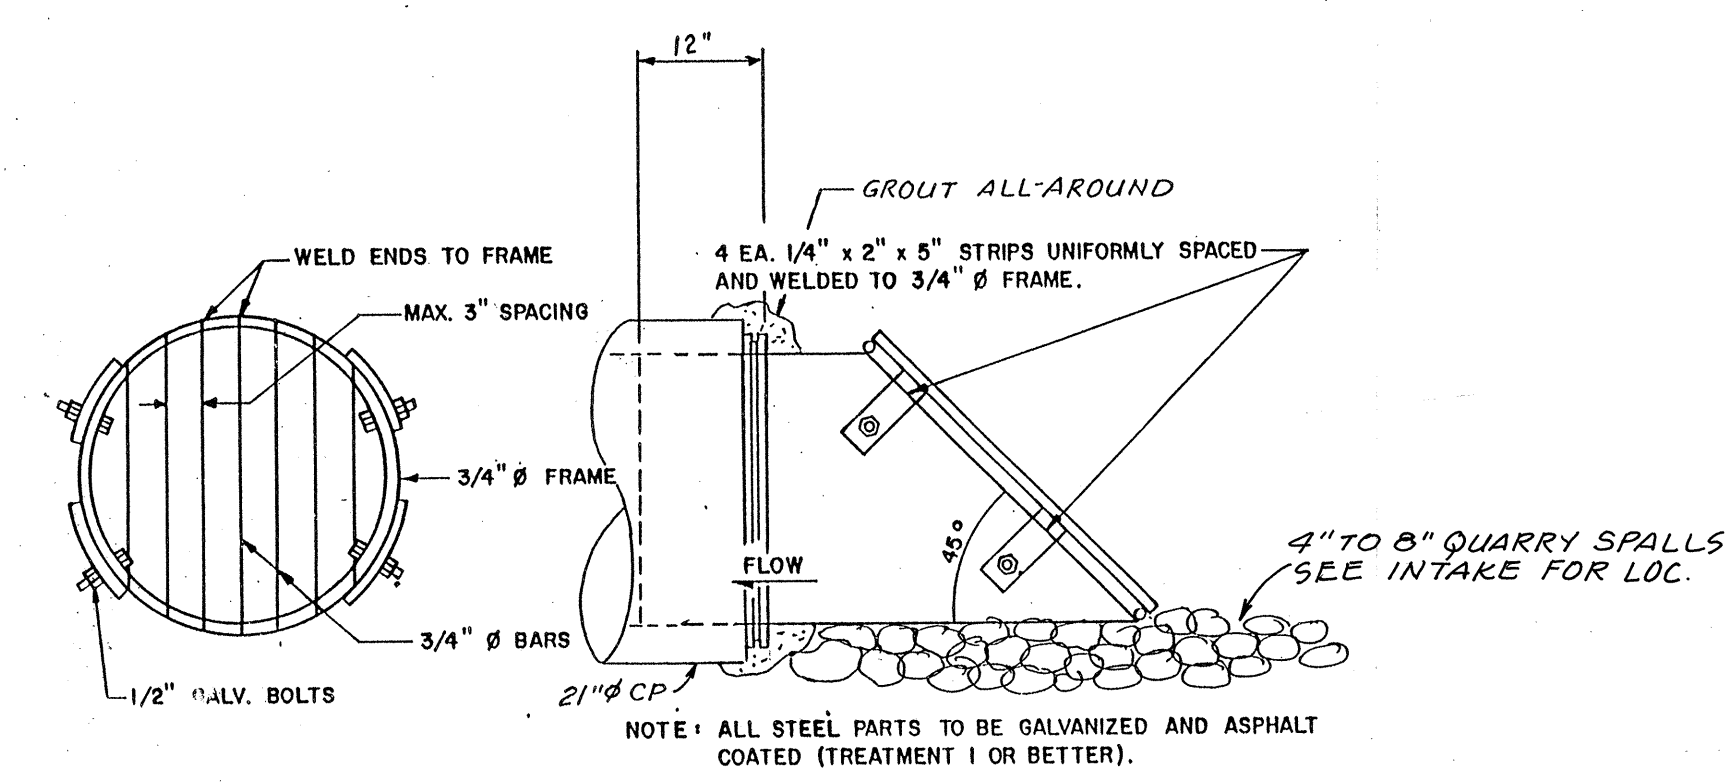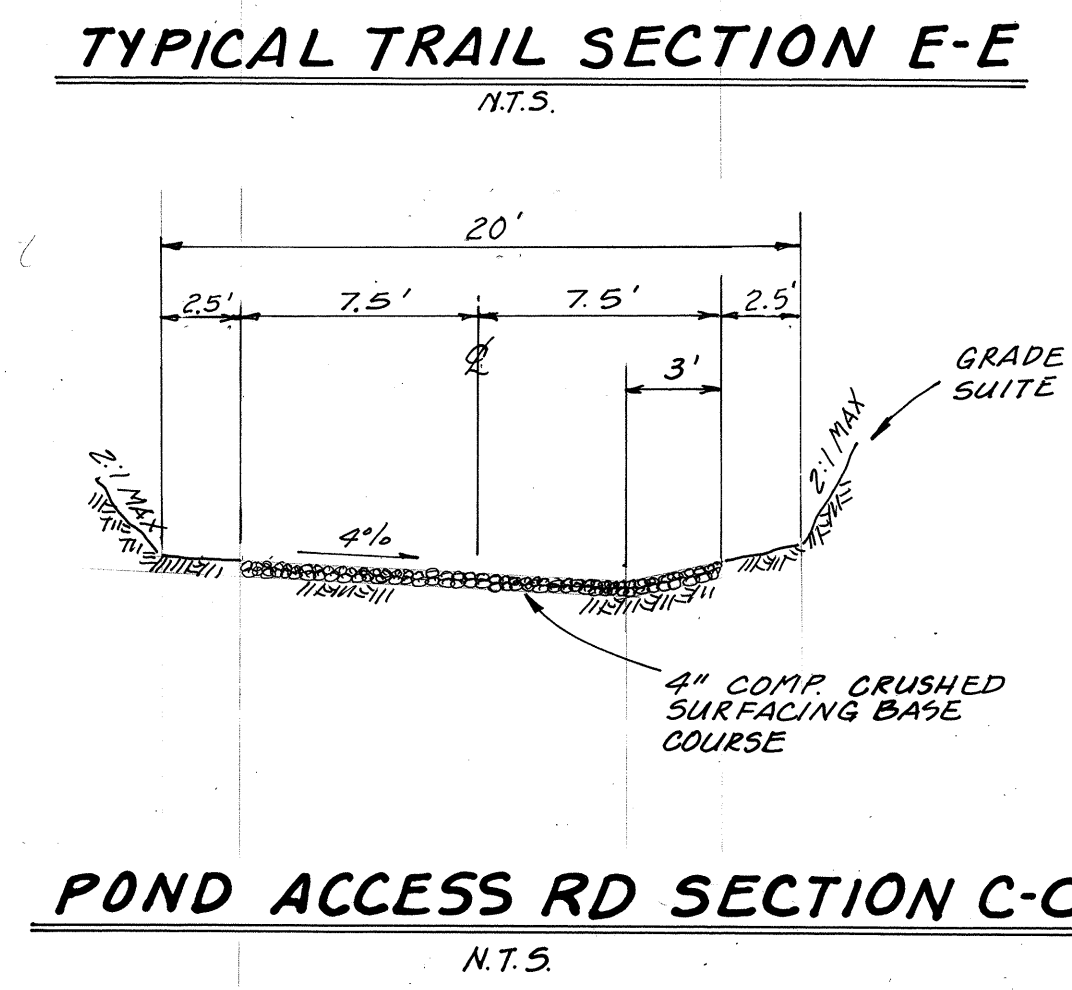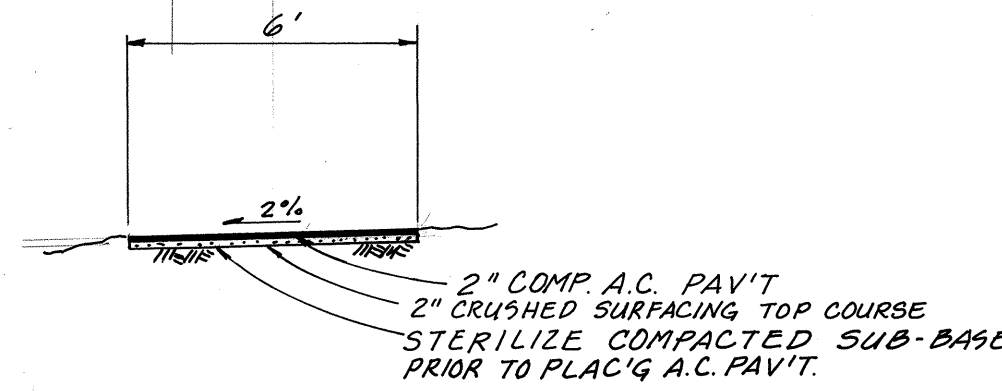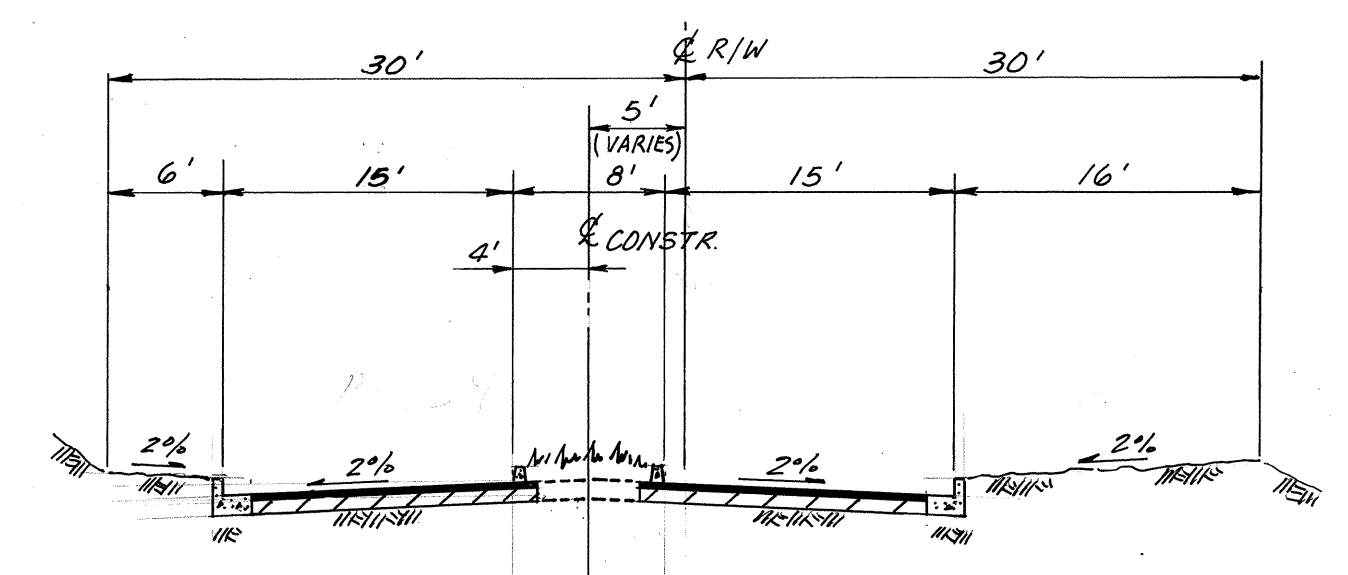



**TRASH SCREEN DETAIL INTAKE #34A**  
N.T.S.

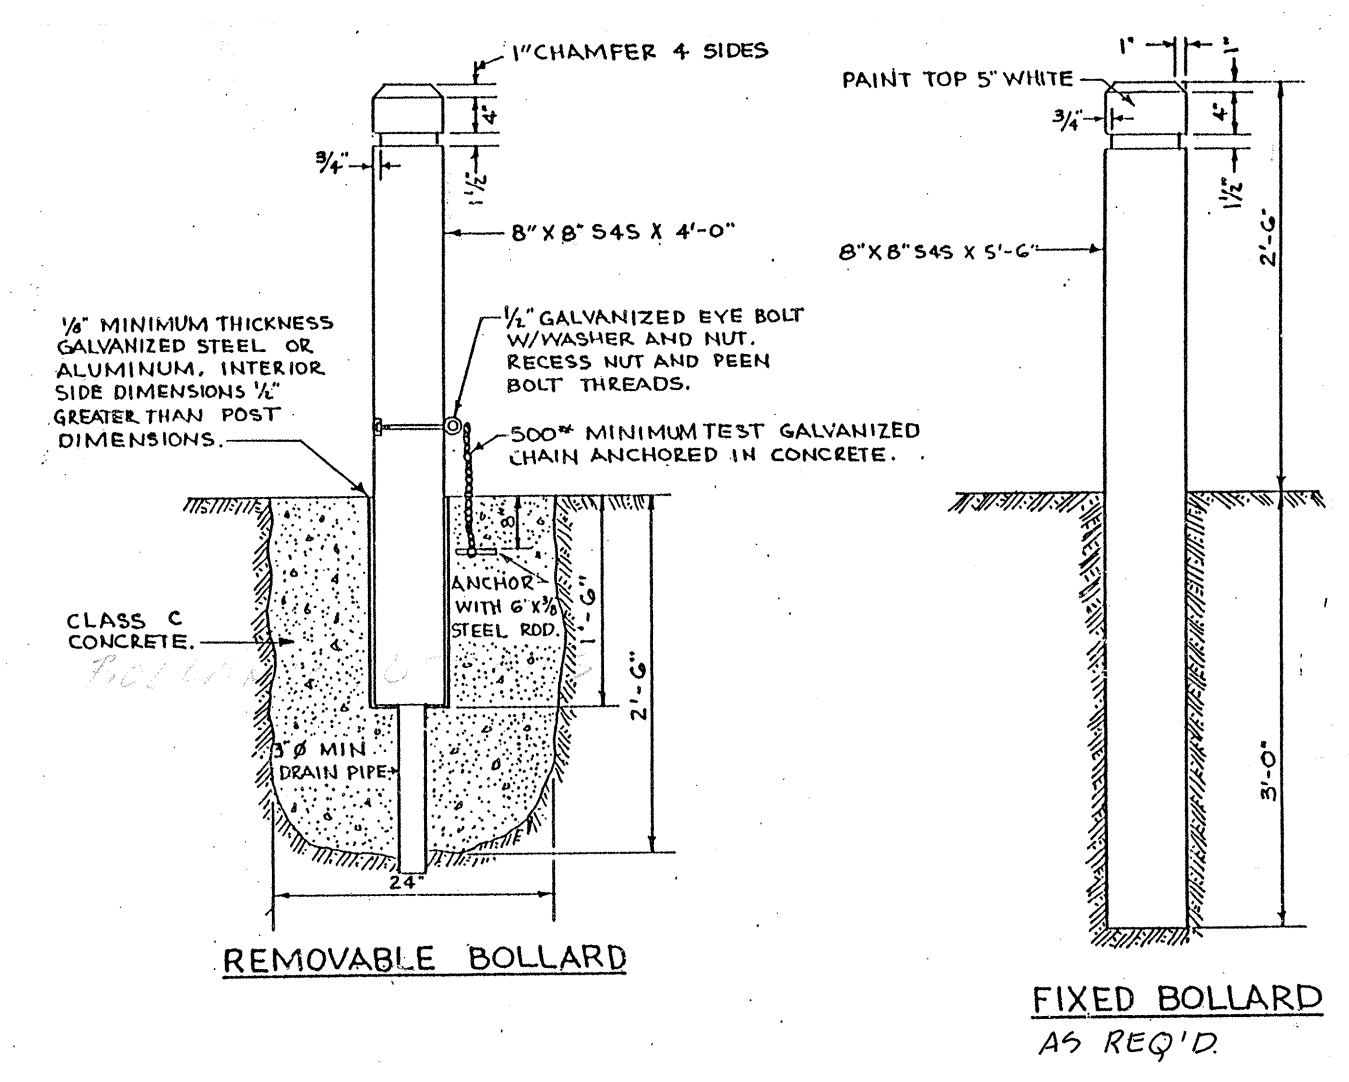



**BOLLARD DETAIL**  
N.T.S.

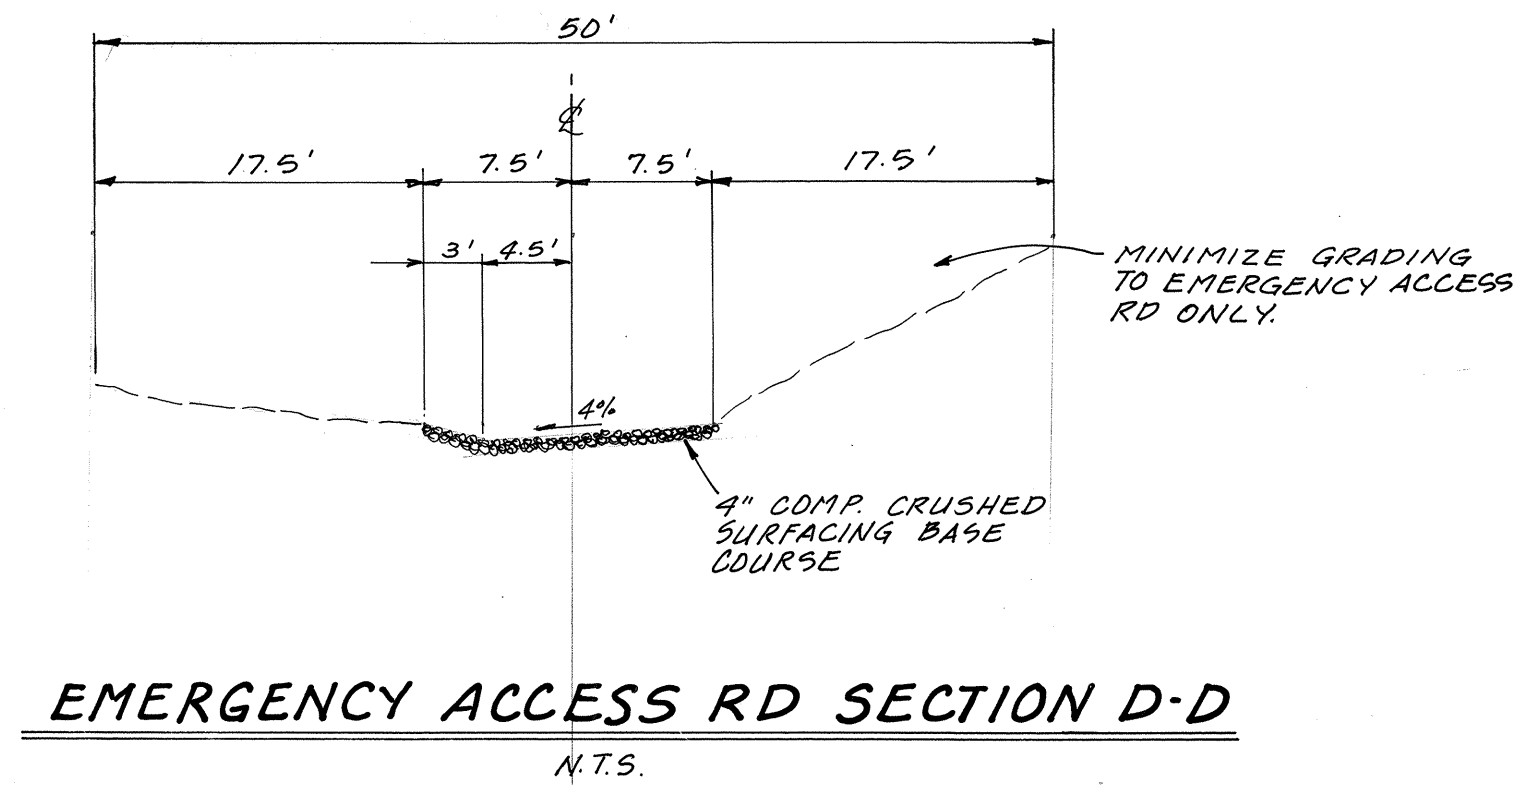

**EMERGENCY ACCESS RD SECTION D-D**  
N.T.S.

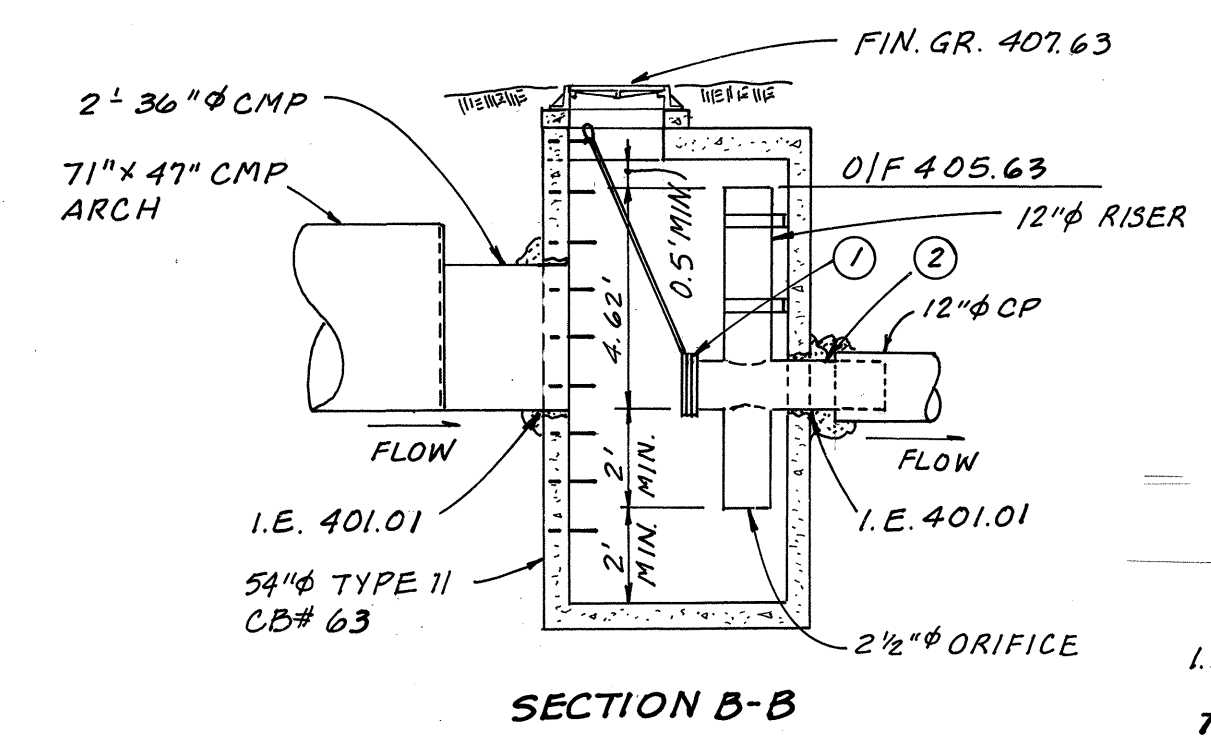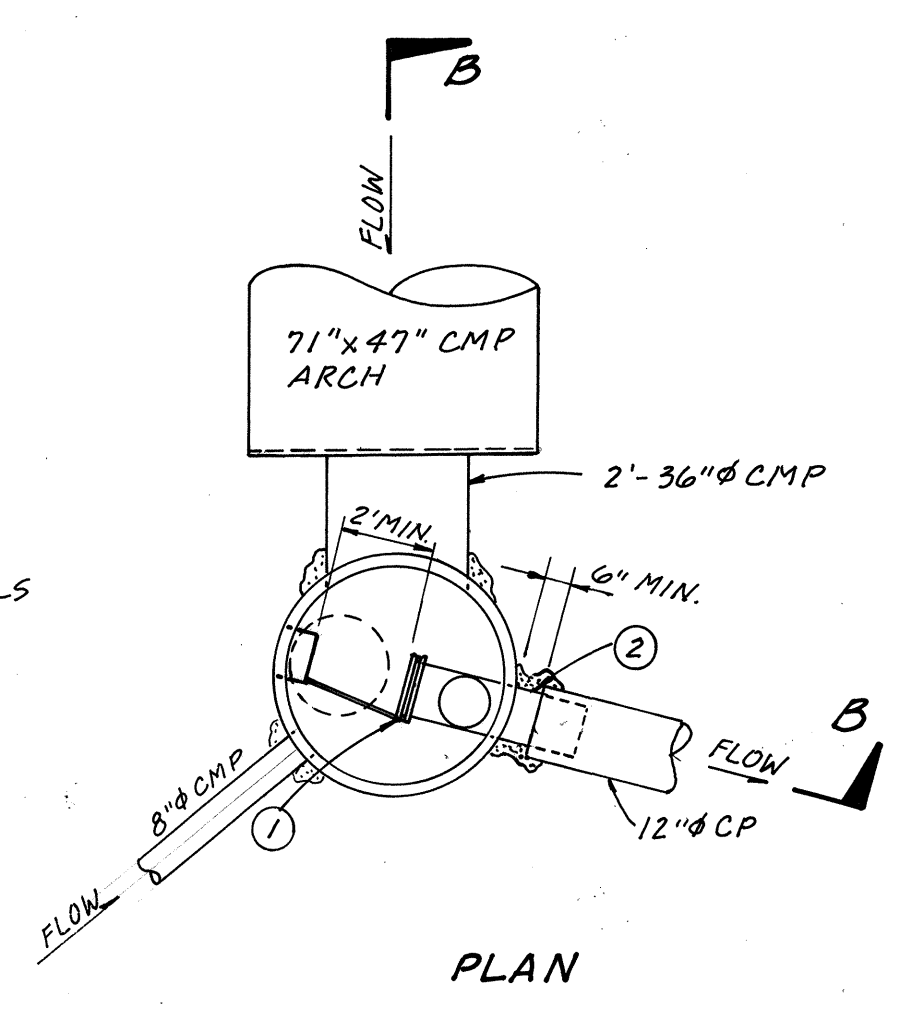

**CB#1 & 63 w/ RESTRICTOR DETAILS**  
SCALE: 1"=4'

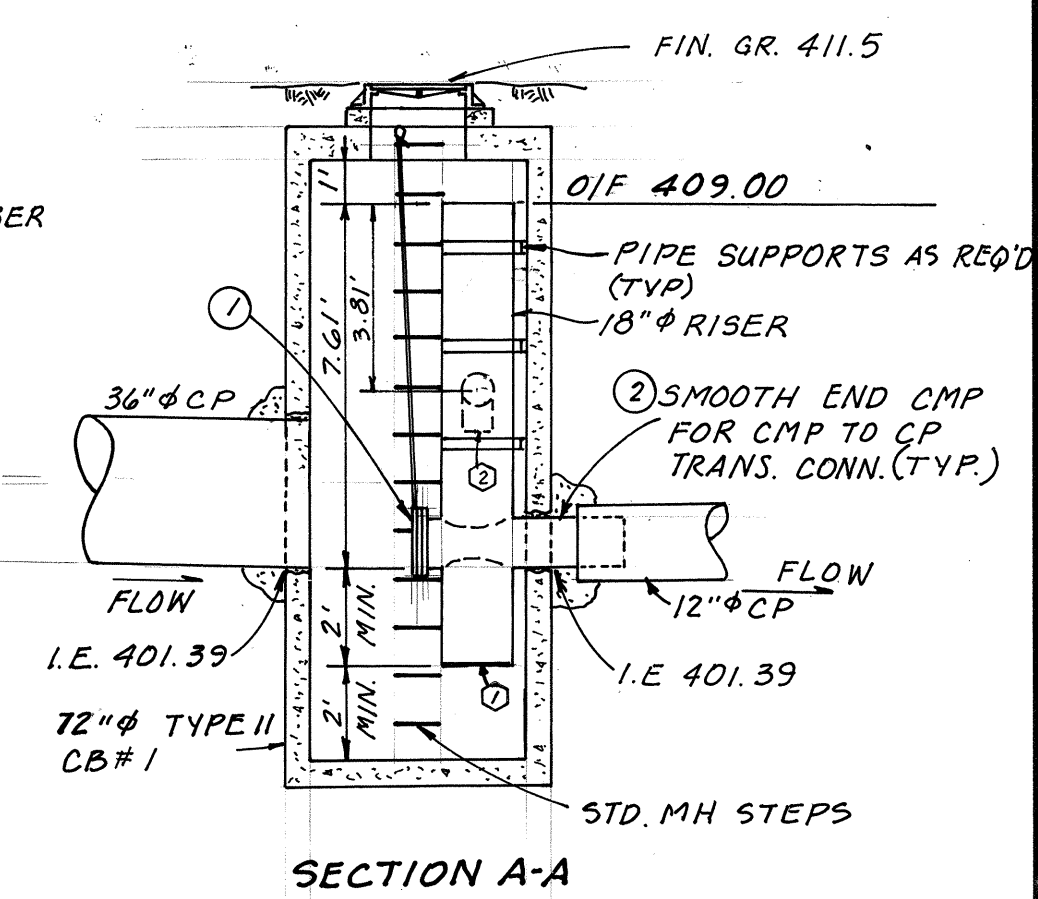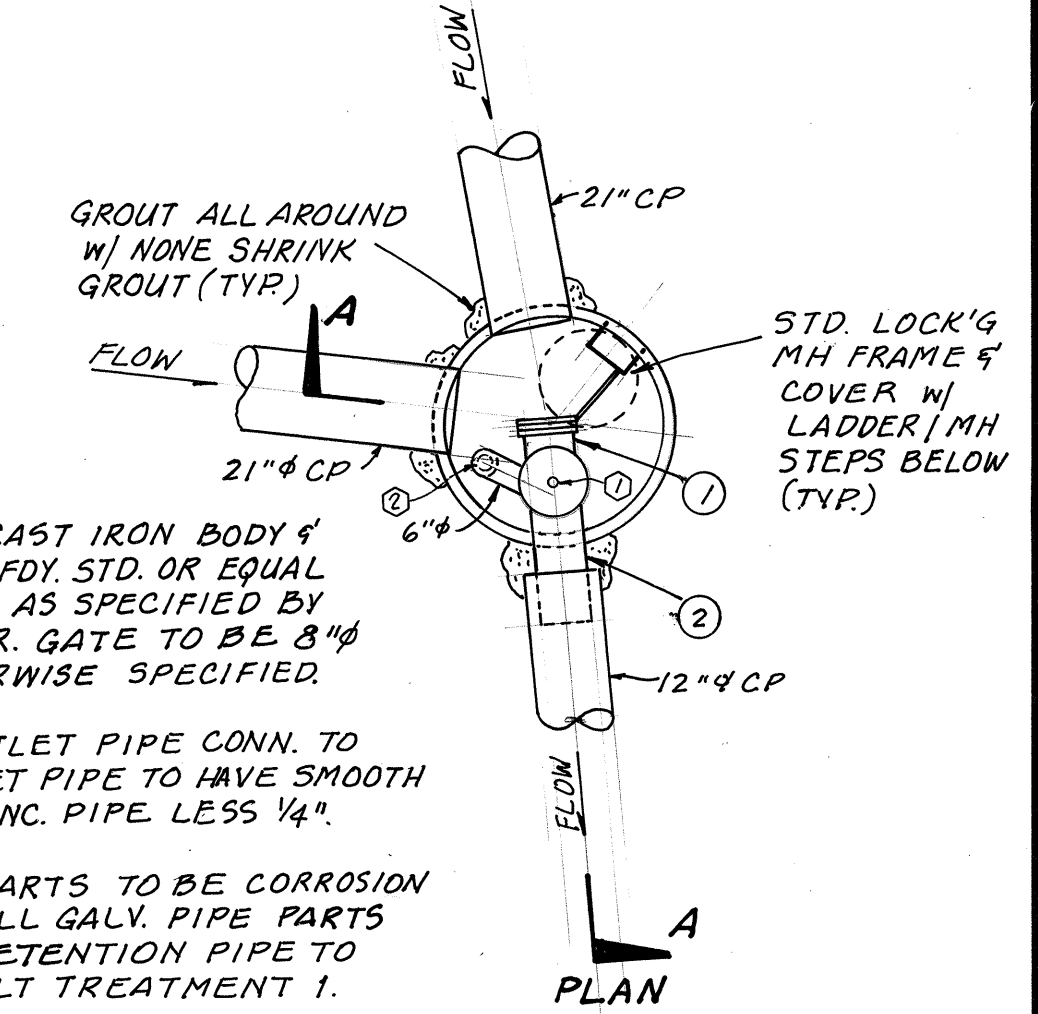

- NOTES:**
1. SHEAR GATE, CAST IRON BODY & GATE, OLYMPIC F.D.Y. STD. OR EQUAL WITH LIFT ROD AS SPECIFIED BY MANUFACTURER. GATE TO BE 8" UNLESS OTHERWISE SPECIFIED.
  2. IF METAL OUTLET PIPE CONN. TO CP, THE OUTLET PIPE TO HAVE SMOOTH O.D. EQ. TO CONC. PIPE LESS 1/4".
  3. ALL METAL PARTS TO BE CORROSION RESISTANT. ALL GALV. PIPE PARTS INCLUDING DETENTION PIPE TO HAVE ASPHALT TREATMENT 1.

- GENERAL NOTES:**
1. All construction shall conform to the standards and specifications of the City of Mill Creek and the latest APWA requirements.
  2. Before any construction activity occurs, a pre-construction meeting must be held with the city engineer.
  3. All sediment/erosion facilities must be in place and operational prior to clearing and construction activities.
  4. All disturbed areas shall be hydroseeded and/or mulched if left unworked for over 30 days.
  5. All pipe and appurtenances shall be laid on a properly prepared foundation in accordance with Section 7-02.3(1) of the current State of Washington Standard Specifications for Road and Bridge Construction. This shall include necessary leveling of the trench bottom or the top of the foundation material as well as placement and compaction of required bedding material to uniform grade so that the entire length of the pipe will be supported on a uniformly dense unyielding base. If the native material in the bottom of the trench meets the requirements for "Gravel Backfill for Pipe Bedding" the first lift of pipe bedding may be omitted provided the material in the bottom of the trench is loosened, regraded and compacted to form a dense unyielding base.
  6. All building downspouts and footing drains shall be connected to the storm drainage system, unless otherwise approved by the City.
  7. All fill areas shall be compacted in maximum 8-inch lifts and compacted to 95% of the maximum dry density per ASTM D-1557.
  8. All trench backfill material shall be compacted to 95% of the maximum dry density per ASTM D-1557.
  9. Storm drainage pipe shall be as follows:  
6" PVC LOT DRAIN: ASTM 9034 SDR 35.  
8" CMP, aluminum 16 gauge, 1 1/2"x1/3" corr.  
12" CMP, aluminum 16 gauge, 2 2/3"x1/2" corr.  
12", 15" and 18" concrete, NRCP, C-14, Class 2.  
21" concrete, reinforced ASTM C-76, Class IV.
- Alternate:  
18" and 21", aluminum "Smoothwall" Spiral Rip Pipe, 16 gauge, 3/4"x3/4" Ribs @ 7 1/2" O.C.
- 6" PVC LOT DRAIN SHALL BE LAID AT MINIMUM SLOPE OF 1% WITH 2' MINIMUM COVER. A MAXIMUM OF 7 LOTS MAY BE SERVED WITH A 6" DRAIN, MORE THAN 7 LOTS REQUIRES AN 8" PVC DRAIN @ 1% SLOPE.
10. Concrete rolled curb shall be per Snohomish County Standard drawing D-9.
  11. Concrete vertical curb and gutter shall be per Snohomish County Standard Drawing D-9.


49510.52 ct

**HIGHLANDS**

*Alan Newhill*  
APPROVED BY THE CITY OF MILL CREEK DATE 8-15-89

STREET AND  
STORM DRAINAGE  
DETAILS

FOXGLOVE AT MILL CREEK  
PACIFIC PROPERTIES, INC.  
MILL CREEK, WASHINGTON

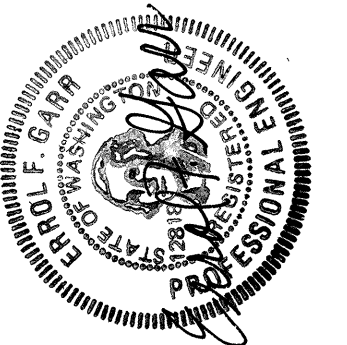

**David Evans and Associates, Inc.**  
501 10TH AVE. S.E. BELLEVUE, WA 98004 206/465-3071

|         |                                 |
|---------|---------------------------------|
| 7-15-88 | REV. PIPE SIZES CB#1 TO 72" & 4 |
| 5-18-88 | ADD 6" PVC LOT DRAIN NOTE       |
| 4-20-88 | REV. PER CITY COMMENTS          |

|                |                    |
|----------------|--------------------|
| 3              | OF THIRTEEN SHEETS |
| SCALE AS NOTED | DRAWN J.B.         |
| DATE 3-7-89    | CHECKED J.B.       |
| FILE ENW 024   | DATE N.K.H.        |



| Catch Basin No. | Type   | Station Offset   | Rim/Grate Elev(Rim/Gr) | Rim/Grate Elev(Rim/Gr) | Invert Elev(I.E.)                                                              |
|-----------------|--------|------------------|------------------------|------------------------|--------------------------------------------------------------------------------|
| 38.             | II-48" | 9+74.57-17.25RT  | Grate                  | 413.77                 | 404.13-18"<br>403.88-21"<br>407.39-12"<br>408.38-12"<br>408.77-8"<br>410.70-8" |
| 39.             | I      | 9+19.35-18.17RT  | Grate                  | 413.37                 | 409.37-12"                                                                     |
| 39A.            | Inlet  | 9+19.35-18.17LT  | Grate                  | 413.37                 | 409.37-12"                                                                     |
| 40.             | I      | 8+64.00-19.00RT  | Rim                    | 413.97                 | 409.37-12"                                                                     |
| 41.             | I      | 0+55.21-14.17LT  | Grate                  | 413.53                 | 409.37-12"<br>410.30-8"<br>410.66-8"                                           |
| 41A.            | Inlet  | 0+55.21-14.17RT  | Grate                  | 413.53                 | 409.37-12"<br>410.30-8"<br>410.66-8"                                           |
| 42.             | II-48" | 11+42.00-28.25RT | Grate                  | 413.30                 | 405.23-12"<br>405.00-18"<br>408.10-12"                                         |
| 45.             | I      |                  | Grate                  | 412.82                 | 409.82-12"                                                                     |
| 44.             | II-48" | 1+00.00-14.17RT  | Grate                  | 411.73                 | 405.89-12"                                                                     |
| 45.             | I      | 1+91.00-14.17RT  | Grate                  | 410.57                 | 406.57-12"                                                                     |
| 46.             | I      | 1+91.00-14.17LT  | Grate                  | 410.57                 | 406.57-12"                                                                     |
| 47.             | I      | 4+00.00-14.17LT  | Grate                  | 412.33                 | 407.55-12"                                                                     |
| 47A.            | I      | 4+00.00-14.17RT  | Grate                  | 412.33                 | 407.55-12"                                                                     |
| 48.             | II-48" | 13+14.00-17.25RT | Grate                  | 411.85                 | 406.47-15"                                                                     |
| 49.             | II-48" | 13+14.00-17.25LT | Grate                  | 411.85                 | 406.71-15"                                                                     |


|      |        |                   |       |        |                                                                |
|------|--------|-------------------|-------|--------|----------------------------------------------------------------|
| 50.  | II-48" | 14+10.00-14.00LT  | Rim   | 413.15 | 407.63-12"<br>407.38-15"<br>408.37-12"                         |
| 51.  | I      | 1+14.00-14.17LT   | Grate | 411.56 | 408.58-17"<br>409.90-12"                                       |
| 52.  | I      | 1+14.00-14.17RT   | Grate | 411.56 | 408.58-17"<br>409.90-12"                                       |
| 53.  | I      | 1/4 Delta         | Grate | 412.72 | 409.50-12"                                                     |
| 54.  | I      | 1/2 Delta         | Grate | 412.33 | 409.90-12"                                                     |
| 54A. | Inlet  | 2+83.00-14.17LT   | Grate | 413.38 | 410.71-8"                                                      |
| 54B. | Future | 1+64.17-14.17LT   |       |        | 416.95-12"<br>407.66-12"<br>410.50-8"<br>411.22-8"             |
| 55.  | II-48" | 14+64.07-17.26 LT | Grate | 415.86 | 407.66-12"<br>410.50-8"<br>411.22-8"                           |
| 55A. | Inlet  | 14+64.07-29.11 RT | Grate | 415.86 | 407.66-12"<br>410.50-8"<br>411.22-8"                           |
| 62.  | I      | 3/4 Delta         | Grate | 405.56 | 400.77-12"                                                     |
| 63.  | II-54" | 0+72.25-CONSTR. & | Rim   | 407.63 | 401.01-36", 12"<br>402.15-8"<br>402.95-8"                      |
| 63A. | Inlet  | 3/4 Delta         | Grate | 405.63 | 402.15-8"<br>402.95-8"                                         |
| 64.  | II-54" | 2+12.25-CONSTR. & | Rim   | 414.40 | 401.71-36"<br>404.62-12", 410.92-8"<br>409.76-12"<br>409.91-8" |
| 65.  | I      | 1/4 Delta         | Grate | 414.76 | 409.91-8"                                                      |
| 64A. | Inlet  | 2+12.25-18.17RT   | Grate | 413.92 | 410.88-8"                                                      |
| 66.  | I      | 4+12.00-18.17LT   | Grate | 412.97 | 413.26-12"<br>413.59-8"                                        |
| 66A. | Inlet  | 4+12.00-18.17RT   | Grate | 412.97 | 413.26-12"<br>413.59-8"                                        |
| 67.  | I      | 8+9.00-14.17LT    | Grate | 411.37 | 406.37-12"<br>406.70-8"                                        |
| 67A. | Inlet  | 8+9.00-14.17RT    | Grate | 411.37 | 406.37-12"<br>406.70-8"                                        |

NOTES:

- TRANSITION FROM ROLLED CURB (RC) TO VERTICAL CURB (VC) TO BE AT WHEELCHAIR RAMPS OR 1/2 d.
- ALL CURB RADII ARE TO THE FACE OF VERTICAL CURB & GUTTER AND TO THE FLOWLINE (R) OF ROLLED CURB & GUTTER.

"SEE BELOW LEFT" MATCH LINE "A"


"RECORD PLAT OF 200300 LITTLE LAKES"

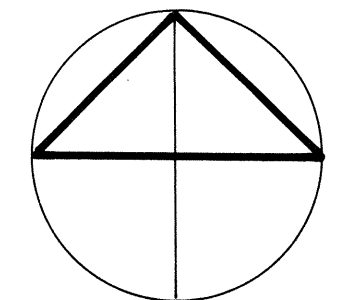

NORTH  
1" = 50'

THE HIGHLANDS AT MILL CREEK

Grate elevation + 0.60' to top of vertical curb and gutter.  
Grate elevation + 0.43' to top of rolled curb and gutter.  
Rim = STD manhole ring and cover.  
Grate = STD metal frame and grate for catch basin and inlet.

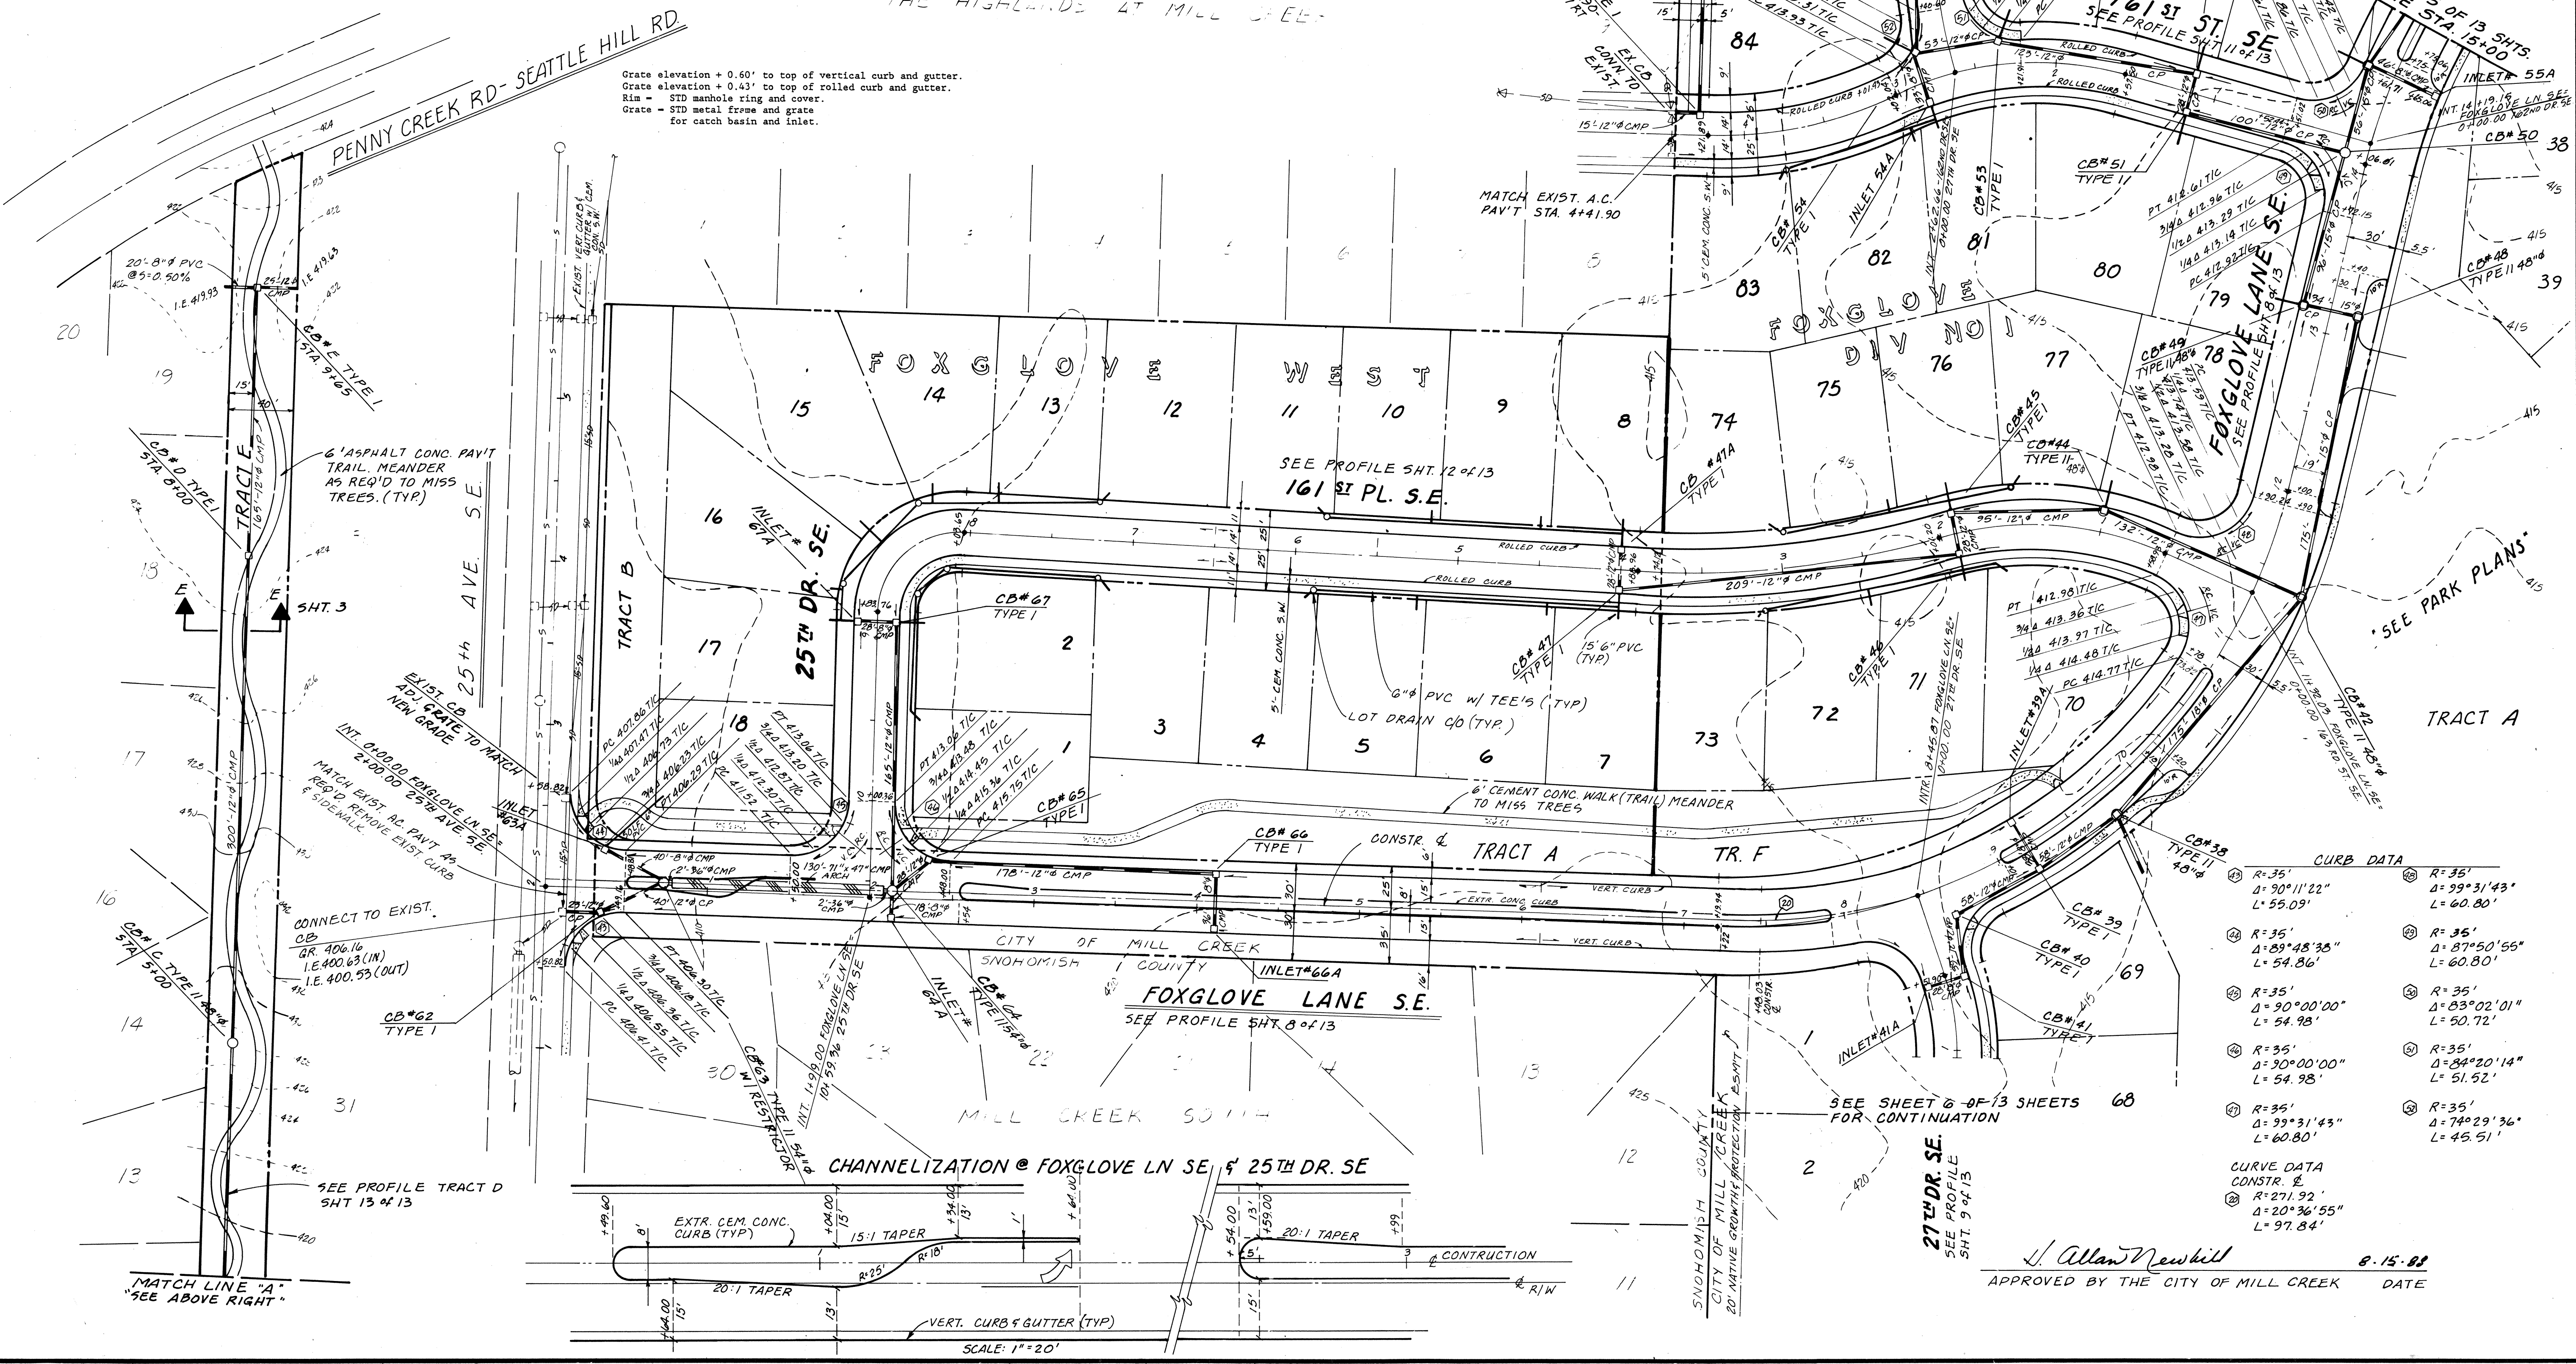

| CURB DATA                          |                                    |
|------------------------------------|------------------------------------|
| ⊙ R=35'<br>Δ=90°11'22"<br>L=55.09' | ⊙ R=35'<br>Δ=99°31'43"<br>L=60.80' |
| ⊙ R=35'<br>Δ=89°48'35"<br>L=54.86' | ⊙ R=35'<br>Δ=87°50'55"<br>L=60.80' |
| ⊙ R=35'<br>Δ=90°00'00"<br>L=54.98' | ⊙ R=35'<br>Δ=83°02'01"<br>L=50.72' |
| ⊙ R=35'<br>Δ=90°00'00"<br>L=54.98' | ⊙ R=35'<br>Δ=84°20'14"<br>L=51.52' |
| ⊙ R=35'<br>Δ=99°31'43"<br>L=60.80' | ⊙ R=35'<br>Δ=74°29'36"<br>L=45.51' |

| CURVE DATA                             |  |
|----------------------------------------|--|
| ⊙ R=271.92'<br>Δ=20°36'55"<br>L=97.84' |  |

APPROVED BY THE CITY OF MILL CREEK DATE 8-15-81

STREET AND STORM DRAINAGE PLAN  
FOXGLOVE AT MILL CREEK  
PACIFIC PROPERTIES, INC.  
MILL CREEK, WASHINGTON



DAVID EVANS AND ASSOCIATES, INC.  
501 10TH AVE. S.E. BELLEVUE, WASH. 98004-2004 (425) 485-3571  
REVISIONS:  
5. 8-9-88 C.O.B. Lot 85  
4. 7-20-88 LOT CLEANOUTS, ROAD, RADI  
3. 6-4-88 REV. R.D. GRAPES  
2. 5-18-86 ADD LOT CLEANOUTS  
1. 4-20-86 REV. LOT NOS. & PERCENTY  
SCALE 1"=50'H.  
DATE 3-7-85  
ENR 024  
CHECKED M.K.H.  
OF THIRTEEN SHEETS  
DRAWN J.B.  
DATE 3-7-85





CATCH BASIN SCHEDULE

| Catch Basin No. | Type             | Station          | Rim/Grate       | Rim/Grate Elev(Rim/Gc) | Invert Elev(I.E.)                                                                    |
|-----------------|------------------|------------------|-----------------|------------------------|--------------------------------------------------------------------------------------|
| 18.             | II-48"           | 14+64-13.25RT    | Grate           | 417.91 419.49          | 410.64<br>410-96-18"                                                                 |
| 19.             | II-48"           | 16+11.00-17RT    | Rim             | 416.47 417.61          | 410-24-18" 412.11<br>413-09-8" 412.61                                                |
| 19A.            | Inlet            | 16+11.00-14.17LT | Grate           | 416.34 417.61          | 413-09-8" 412.61                                                                     |
| 20.             | II-48"           | 18+50.00-13.25RT | Grate           | 420.97 421.02          | 419-49-18" 413.14<br>413-36-8" 411.92                                                |
| 20A.            | Inlet            | 18+50.00-14.17LT | Grate           | 420.52 421.00          | 413-36-8" 411.92                                                                     |
| 21.             | II-48"           | 20+40.00-18.00RT | Rim             | 424.01 425.30          | 415-06-12" 414.60<br>419-06-18" 414.09                                               |
| 21.             | II-48"           | 21+07.00-17.25RT | Grate           | 425.70 425.91          | 413-36-12" 411.51<br>420-30-8" 423.30                                                |
| 25A.            | Inlet            | 21+07.00-18.17LT | Grate           | 423.78 425.90          | 413-36-8" 421.25                                                                     |
| 26.             | II-48"           | 23+54.00-17.00RT | Rim             | 430.54                 | 421.17-12" 422.09-12" 427.18-12"                                                     |
| 26A.            | Future Conn/Stub | 25+94.00-18.17RT |                 |                        |                                                                                      |
| 27.             | I                | 1/2 Delta        | Thru Curb Inlet | 427.67 425.44          | 425-17-12" 412.49                                                                    |
| 56.             | II-48"           | 16+55.00-18.00LT | Rim             | 417.10 417.20          | 408.63-12" 417.15"<br>409-22-12" 409.53"<br>413-09-12" 411.23"<br>409-36-12" 409.55" |
| 57.             | II-48"           | 1+25.00-13.25LT  | Grate           | 415.44 415.89          | 413-07-12" 412.20<br>413-40-8" 412.69<br>412-04-8" 413.01                            |
| 58.             | I                | 2+00.00-14.17LT  | Grate           | 413.38 415.09          | 409.74-12" 410.18                                                                    |
| 58A.            | I                | 1/2 Delta        | Thru Curb Inlet | 412.91 412.99          | 410-24-12" 410.69                                                                    |
| 59.             | I                | 1+08.00-14.17LT  | Grate           | 411.61 415.65          | 413-07-12" 412.20<br>413-40-8" 412.69<br>412-04-8" 413.01                            |
| 59A.            | Inlet            | 1+08.00-14.17RT  | Grate           | 415.61 415.96          | 413-07-12" 412.20<br>413-40-8" 412.69<br>412-04-8" 413.01                            |
| 60.             | I                | 2+70.00-14.17LT  | Grate           | 417.14 417.17          | 413-60-12" 413.31<br>413-93-8" 413.91<br>414-47-8" 415.22                            |
| 60A.            | Inlet            | 2+70.00-14.17RT  | Grate           | 417.14 417.22          | 413-60-12" 413.31<br>413-93-8" 413.91<br>414-47-8" 415.22                            |
| 60B.            | Future Conn/Stub | 3+48.14-14.17LT  |                 |                        | 413-33-12" 414.33                                                                    |
| 61.             | I                | 18+00.00-18.17LT | Grate           | 419.01 419.88          | 416-09-12" 414.18<br>416-42-8" 416.88<br>417-14-8" 417.17                            |
| 61A.            | Inlet            | 18+00.00-18.17RT | Grate           | 419.01 419.82          | 416-09-12" 414.18<br>416-42-8" 416.88<br>417-14-8" 417.17                            |

SHEET 6

|      |                  |                  |                 |               |                                                                                                     |
|------|------------------|------------------|-----------------|---------------|-----------------------------------------------------------------------------------------------------|
| 1.   | II-72"           | 0+45.42-20"LT    | Rim             | 411.50        | 401.39-12" 21"                                                                                      |
| 2.   | II-48"           | 6+95.00-13.25RT  | Grate           | 410.09 410.08 | 402-16-21" 402.08                                                                                   |
| 3.   | II-48"           | 7+90.00-13.25RT  | Grate           | 411.63 411.66 | 405-04-21" 402.93<br>408-09-8" 408.93                                                               |
| 3A.  | Inlet            | 7+90.00-14.17LT  | Grate           | 411.63 411.76 | 405-04-21" 402.93<br>408-09-8" 408.93                                                               |
| 4.   | II-48"           | 9+65.00-14.00RT  | Rim             | 413.49 415.49 | 405-11-15" 404.44<br>404-86-18" 404.14<br>406-61-21" 404.65<br>410-11-8" 410.21<br>410-65-8" 410.21 |
| 4A.  | Inlet            | 9+60.00-14.17LT  | Grate           | 413.32        | 405-11-15" 404.44<br>404-86-18" 404.14<br>406-61-21" 404.65<br>410-11-8" 410.21<br>410-65-8" 410.21 |
| 5.   | II-48"           | 1+09.00-13.75LT  | Grate           | 411.98 412.07 | 406-02-15" 405.91<br>407-88-8" 408.92<br>409-31-8" 409.60                                           |
| 5A.  | Inlet            | 1+09.00-14.17LT  | Grate           | 411.98 412.00 | 406-02-15" 405.91<br>407-88-8" 408.92<br>409-31-8" 409.60                                           |
| 6.   | II-48"           | 1+90.00-14.00RT  | Rim             | 411.93 413.11 | 407-08-12" 407.90 407.90<br>406-89-15" 407.96<br>408-01-12" 408.24                                  |
| 7.   | I                | 1/2 Delta        | Thru Curb Inlet | 410.01 410.41 | 408-01-12" 408.24                                                                                   |
| 8.   | II-48"           | 2+50.00-14.17LT  | Grate           | 413.67 414.02 | 408-67-12" 407.82 407.82<br>410.46-8"                                                               |
| 9.   | II-48"           | 4+00.00-13.25RT  | Grate           | 415.77 416.84 | 410-42-12" 408.41<br>410-08-8" 409.41<br>412-77-8" 412.97                                           |
| 10.  | Inlet            | 4+00.00-14.17LT  | Grate           | 415.77 416.74 | 410-42-12" 408.41<br>410-08-8" 409.41<br>412-77-8" 412.97                                           |
| 11.  | II-48"           | 5+10.00-5.00RT   | Rim             | 417.64 418.80 | 411-81-12" 410.11 410.12, 410.18<br>414-01-8"                                                       |
| 11B. | Future Conn/Stub | 6+54.15-14.17LT  |                 |               | 415-47-12" 411.11                                                                                   |
| 12.  | II-48"           | 1/4 Delta        | Grate           | 416.54 417.01 | 411.94-12" 410.51 410.34                                                                            |
| 13.  | I                | 1/2 Delta        | Thru Curb Inlet | 415.16 413.91 | 413-15-12" 411.30                                                                                   |
| 14.  | II-48"           | 12+15.00-16.00RT | Rim             | 416.30 416.16 | 408-96-18" 408.66<br>409-46-12" 409.16<br>410-48-8" 409.16<br>413-64-8" 413.93                      |
| 14A. | Inlet            | 12+25.00-14.17LT | Grate           | 416.24 416.33 | 413-64-8" 413.93                                                                                    |
| 15.  | I                | 3/4 Delta        | Grate           | 416.68 415.55 | 410-79-12" 410.69<br>412-32-8" 411.15                                                               |
| 15A. | Inlet            | 3/4 Delta        | Grate           | 416.68 415.59 | 410-79-12" 410.69<br>412-32-8" 411.15                                                               |
| 16.  | I                | 1+10.00-14.17RT  | Grate           | 417.13 419.00 | 413-06-12" 415.95                                                                                   |
| 17.  | I                | 2+22.57-14.17RT  | Grate           | 419.62 421.94 | 416-00-12" 417.11<br>416-41-8" 418.17<br>416-95-8" 418.64                                           |
| 17A. | Inlet            | 2+22.57-14.17LT  | Grate           | 419.66 421.24 | 416-00-12" 417.11<br>416-41-8" 418.17<br>416-95-8" 418.64                                           |
| 32.  | Inlet            | 6+29.31-14.17RT  | Grate           | 409.33 409.42 | 406-00-8" 406.77                                                                                    |
| 33.  | II-72"           | 6+29.31-13.25LT  | Grate           | 409.33 409.34 | 401-87-21" 401.99<br>404-02-8" 405.99<br>402-47-21" 402.41                                          |
| 34.  | II-72"           |                  | Rim             | 413.00 411.81 | 402-47-21" 402.41                                                                                   |
| 34A. | Intake           | Trash/Screen     |                 | 403.00 21"    | 403.44                                                                                              |
| 35.  | II-48"           |                  | Rim             | 414.00 413.13 | 402-69-21" 402.83                                                                                   |
| 36.  | II-48"           |                  | Rim             | 416.90 416.61 | 402-90-21" 403.19                                                                                   |
| 37.  | II-48"           |                  | Rim             | 412.50 413.76 | 403-50-21" 404.05                                                                                   |

J. Allan Newbill 8-15-88  
APPROVED BY THE CITY OF MILL CREEK DATE

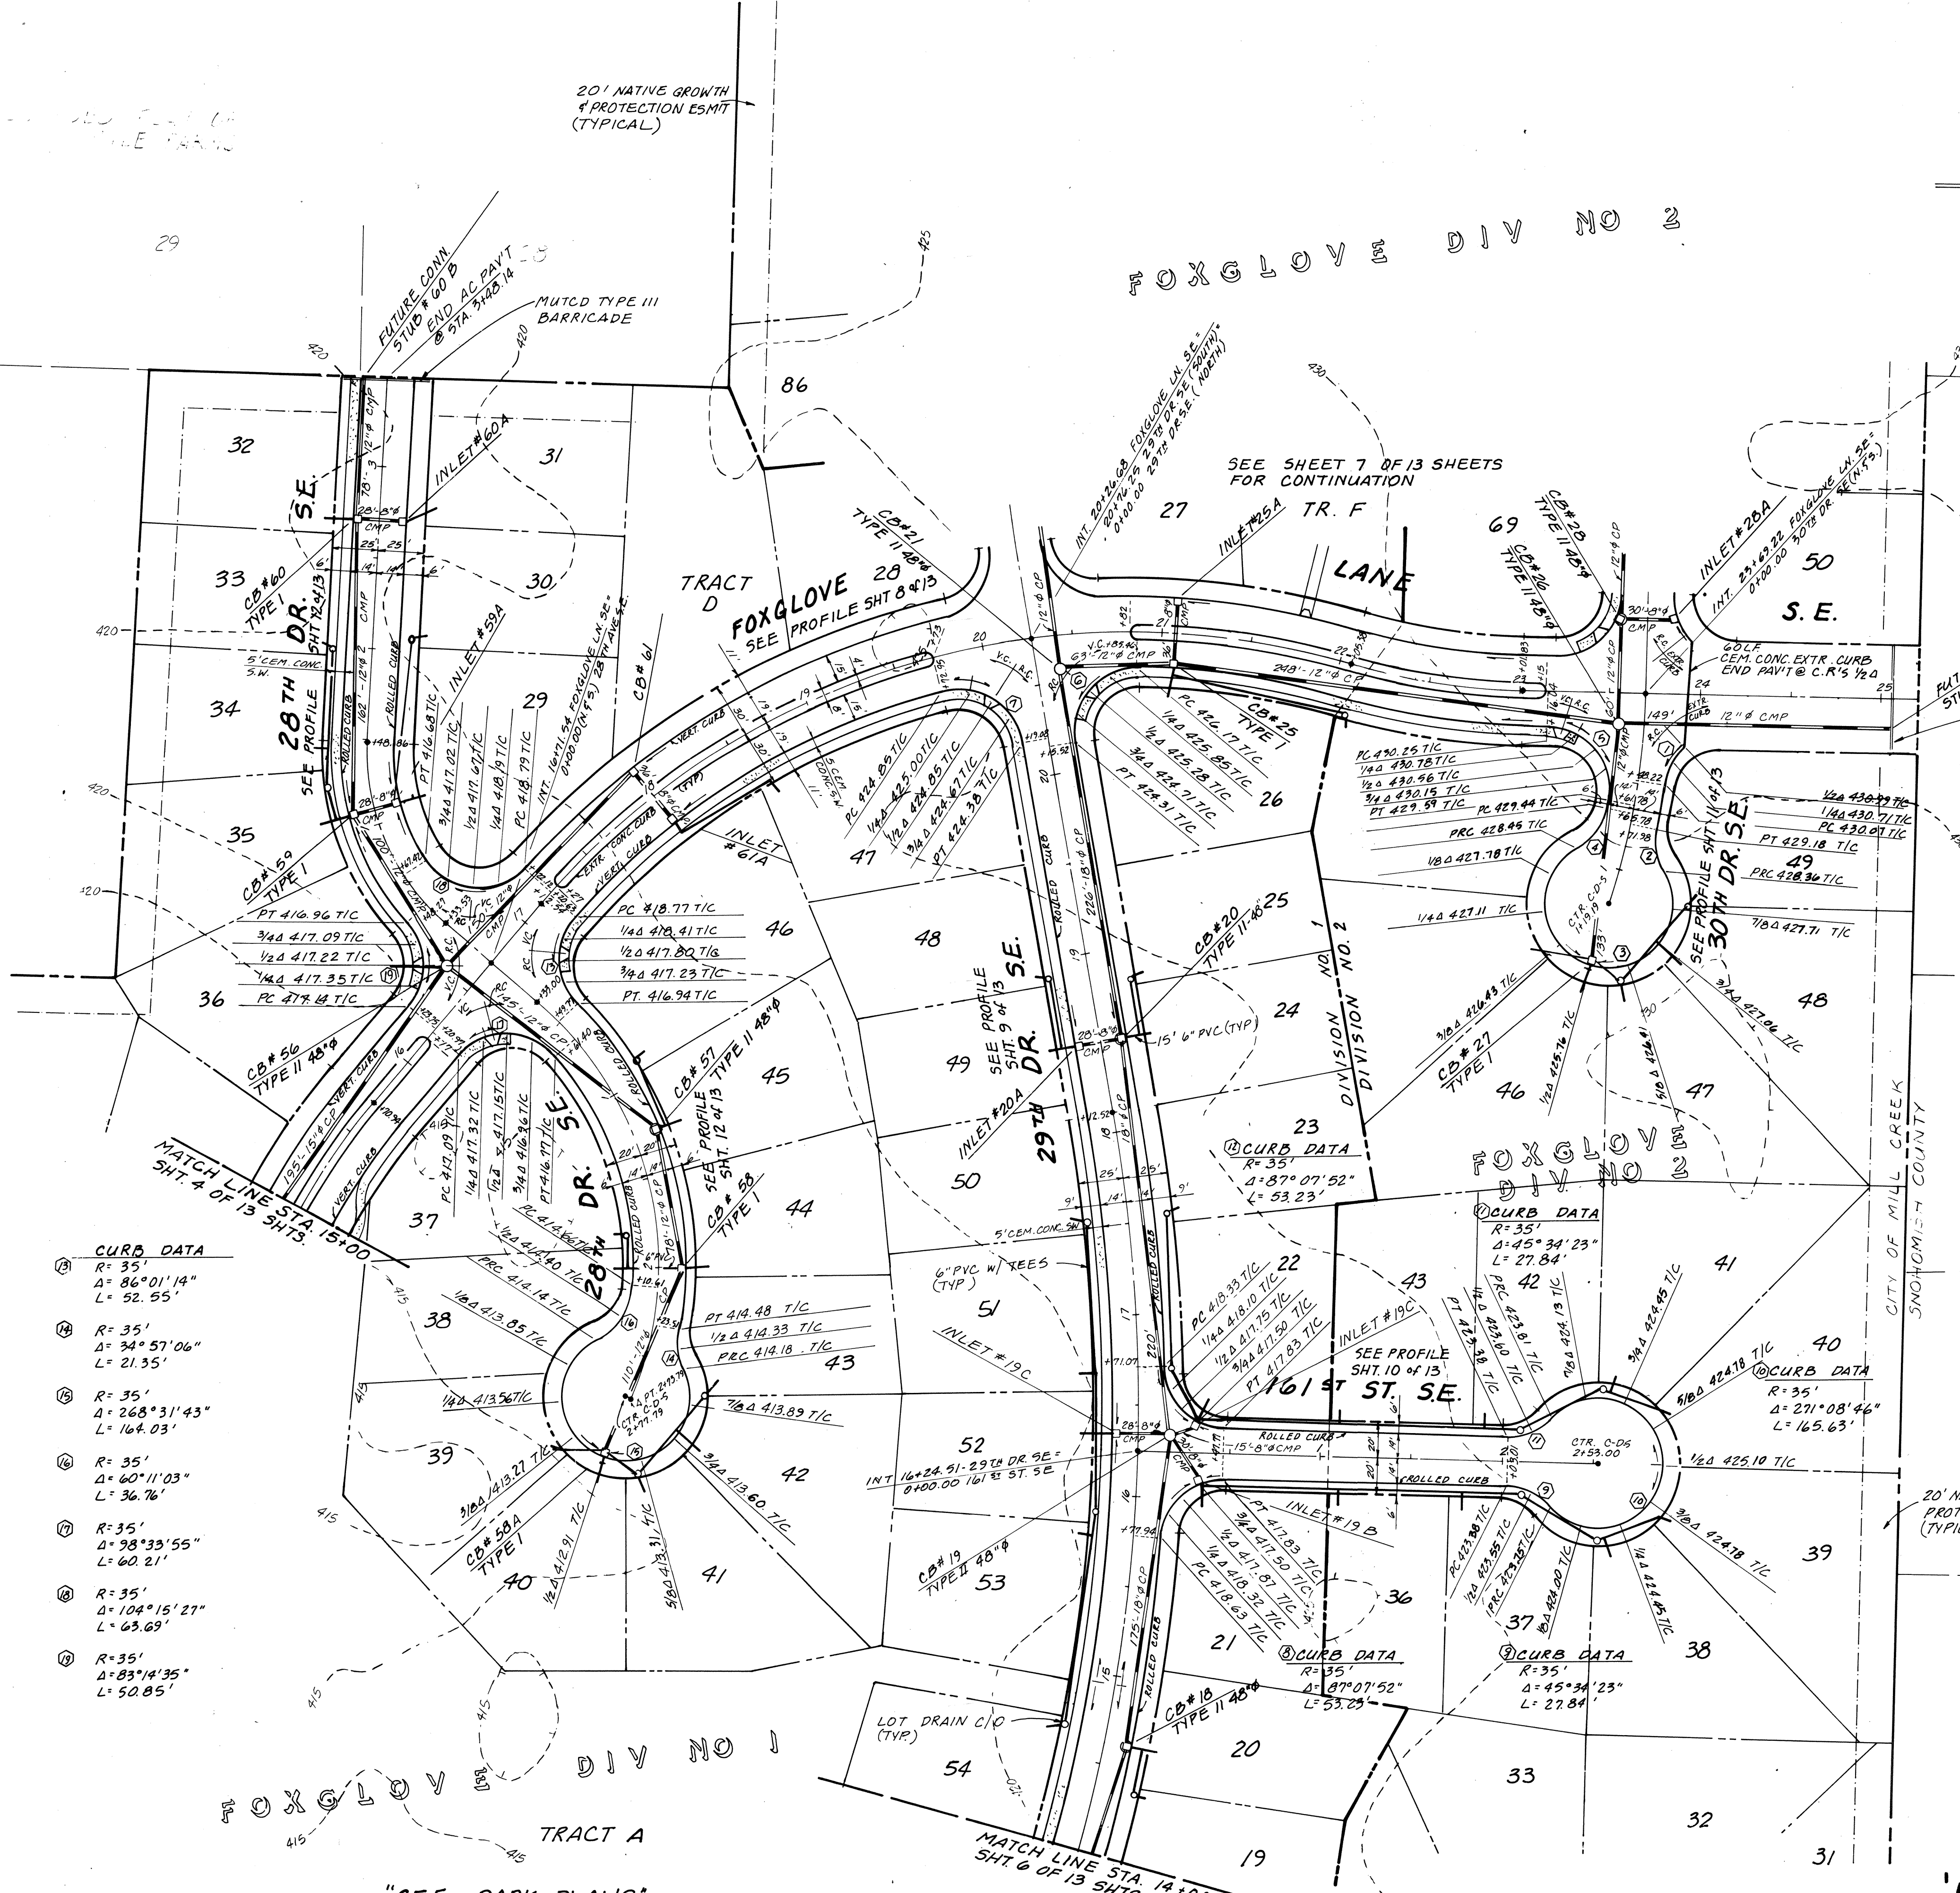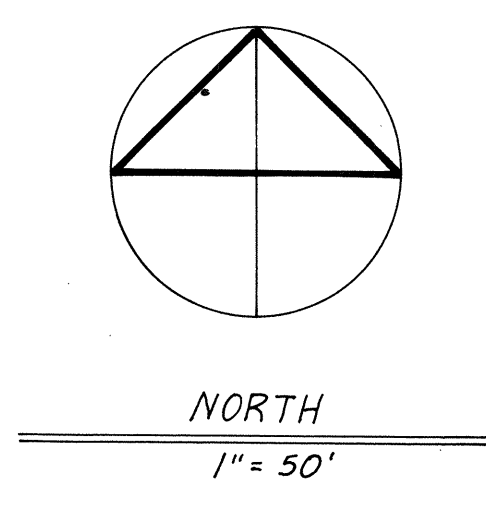

**CURB DATA**

|   |       |              |           |
|---|-------|--------------|-----------|
| 1 | R=35' | Δ=41°32'46"  | L=25.38'  |
| 2 | R=35' | Δ=42°17'22"  | L=25.38'  |
| 3 | R=35' | Δ=270°55'30" | L=165.50' |
| 4 | R=35' | Δ=49°31'22"  | L=30.25'  |
| 5 | R=35' | Δ=98°50'59"  | L=60.38'  |
| 6 | R=35' | Δ=100°01'22" | L=61.10'  |
| 7 | R=35' | Δ=99°58'04"  | L=58.01'  |

NOTES:  
1. TRANSITION FROM ROLLED CURB TO VERTICAL CURB TO BE AT WHEELCHAIR RAMPS OR 1/2 Δ.  
2. ALL CURB RADII ARE TO THE FACE OF VERTICAL CURB & GUTTER AND TO THE FLOWLINE (FL) OF ROLLED CURB & GUTTER.

STREET AND STORM DRAINAGE PLAN  
FOXGLOVE AT MILL CREEK  
PACIFIC PROPERTIES, INC.  
MILL CREEK, WASHINGTON  
DAVID EVANS AND ASSOCIATES, INC.  
501 18TH AVE. S.E. BELLEVUE, WA 98004-2046-3571  
6-14 AUG 89  
5 OF THIRTEEN SHEETS  
SCALE 1"=50' H  
DATE 3-7-88  
ENR 024


'AS-BUILT'  
Aug 89  
HIGHLANDS HDEV-194



WEST  
FOXGLOVE

- NOTES:
1. TRANSITION FROM ROLLED CURB TO VERTICAL CURB TO BE AT WHEELCHAIR RAMPS OR 1/2 Δ.
  2. ALL CURB RADII ARE TO THE FACE OF VERTICAL CURB & GUTTER AND TO THE FLOWLINE (R.) OF ROLLED CURB AND GUTTER.


*J. Allan Newbill* 8-15-88  
 APPROVED BY THE CITY OF MILL CREEK DATE

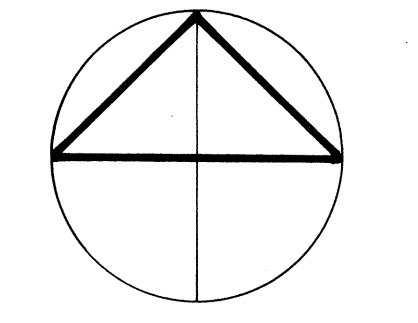

1" = 50'

**CURB DATA**

|    |       |              |           |
|----|-------|--------------|-----------|
| 37 | R=35' | Δ=87°07'52"  | L=53.23'  |
| 38 | R=35' | Δ=87°07'52"  | L=53.23'  |
| 39 | R=35' | Δ=45°34'23"  | L=27.84'  |
| 40 | R=35' | Δ=271°05'46" | L=165.23' |
| 41 | R=35' | Δ=45°34'23"  | L=27.84'  |
| 42 | R=35' | Δ=91°15'15"  | L=55.72'  |

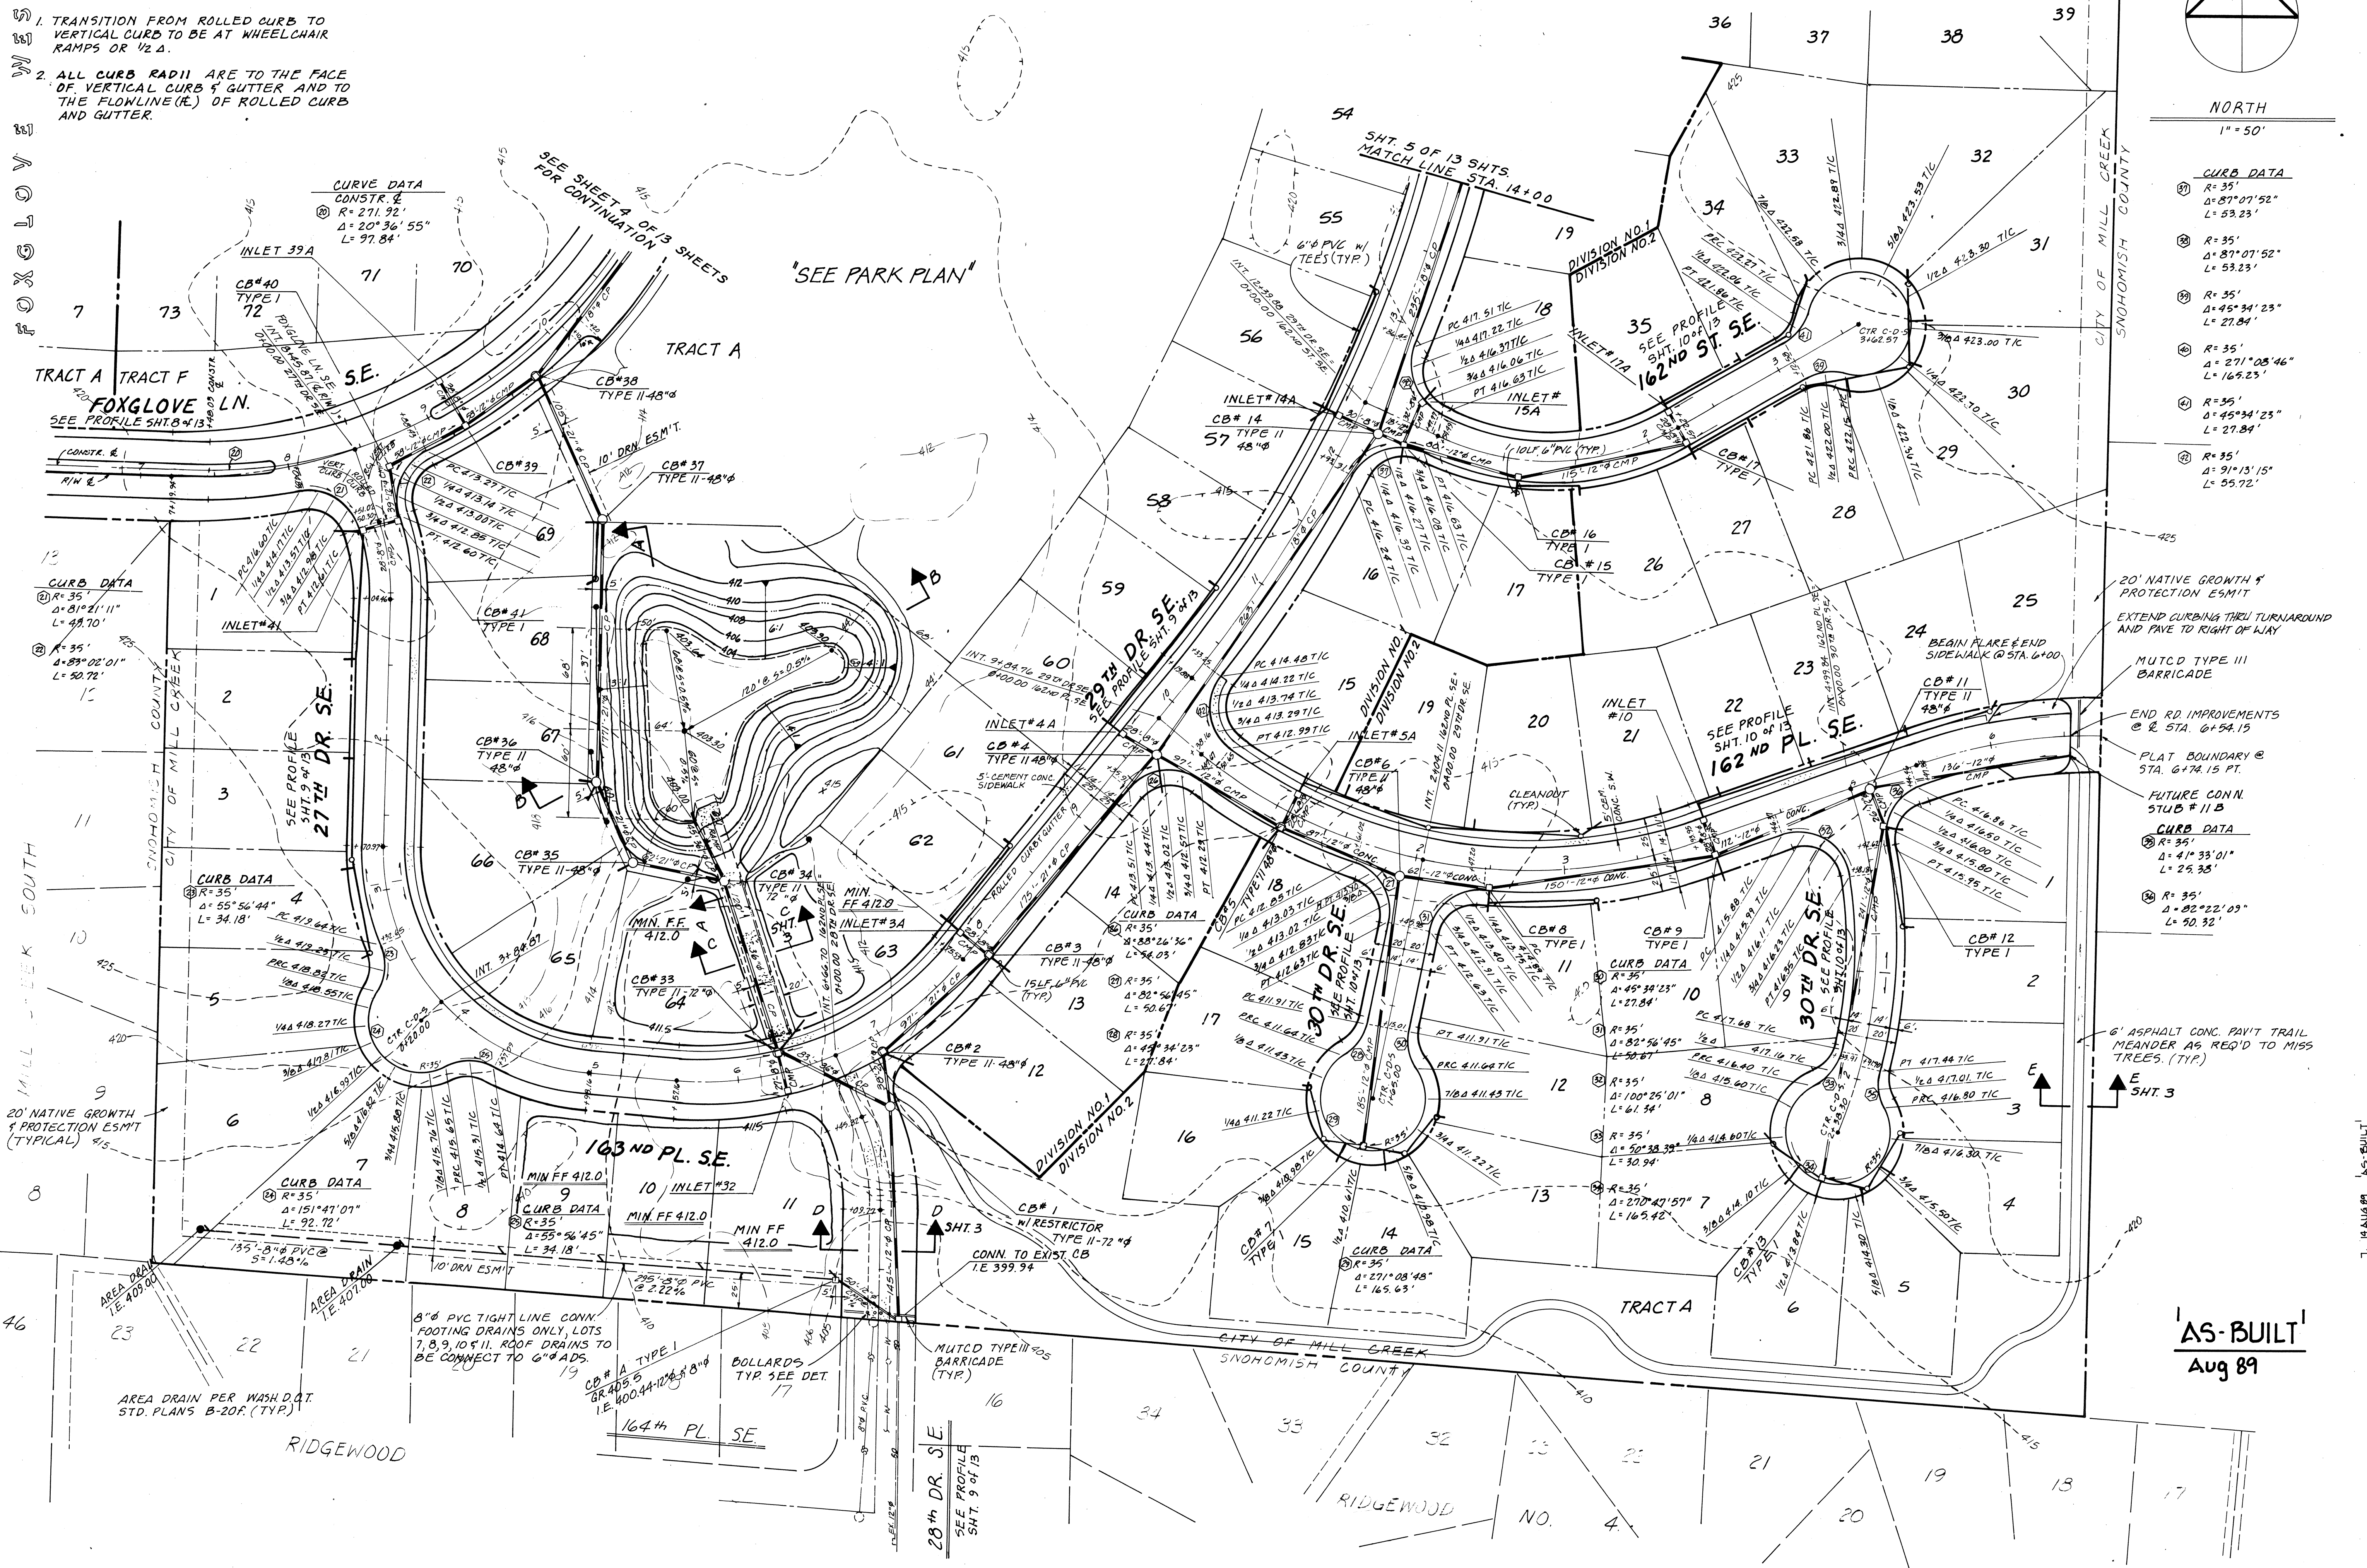

**'AS-BUILT'**  
 Aug 89

STREET AND  
 STORM DRAINAGE  
 PLAN

FOXGLOVE AT MILL CREEK  
 PACIFIC PROPERTIES, INC.  
 MILL CREEK, WASHINGTON





DAVID EVANS AND ASSOCIATES, INC.  
 501 10TH AVENUE, BELLEVUE, WA 98004-2045-3571

|      |         |      |        |
|------|---------|------|--------|
| DATE | 3-7-88  | DRWN | J.B.   |
| CHKD | J.B.    | DRWN | J.B.   |
| DATE | 8-15-88 | CHKD | A.K.H. |
| DATE | 8-15-88 | DRWN | J.B.   |

OF THIRTEEN SHEETS  
 SHEET NO. 6  
 SCALE 1" = 50'  
 DATE 8-15-88  
 CHECKED A.K.H.


HIGHLANDS HDEV-195



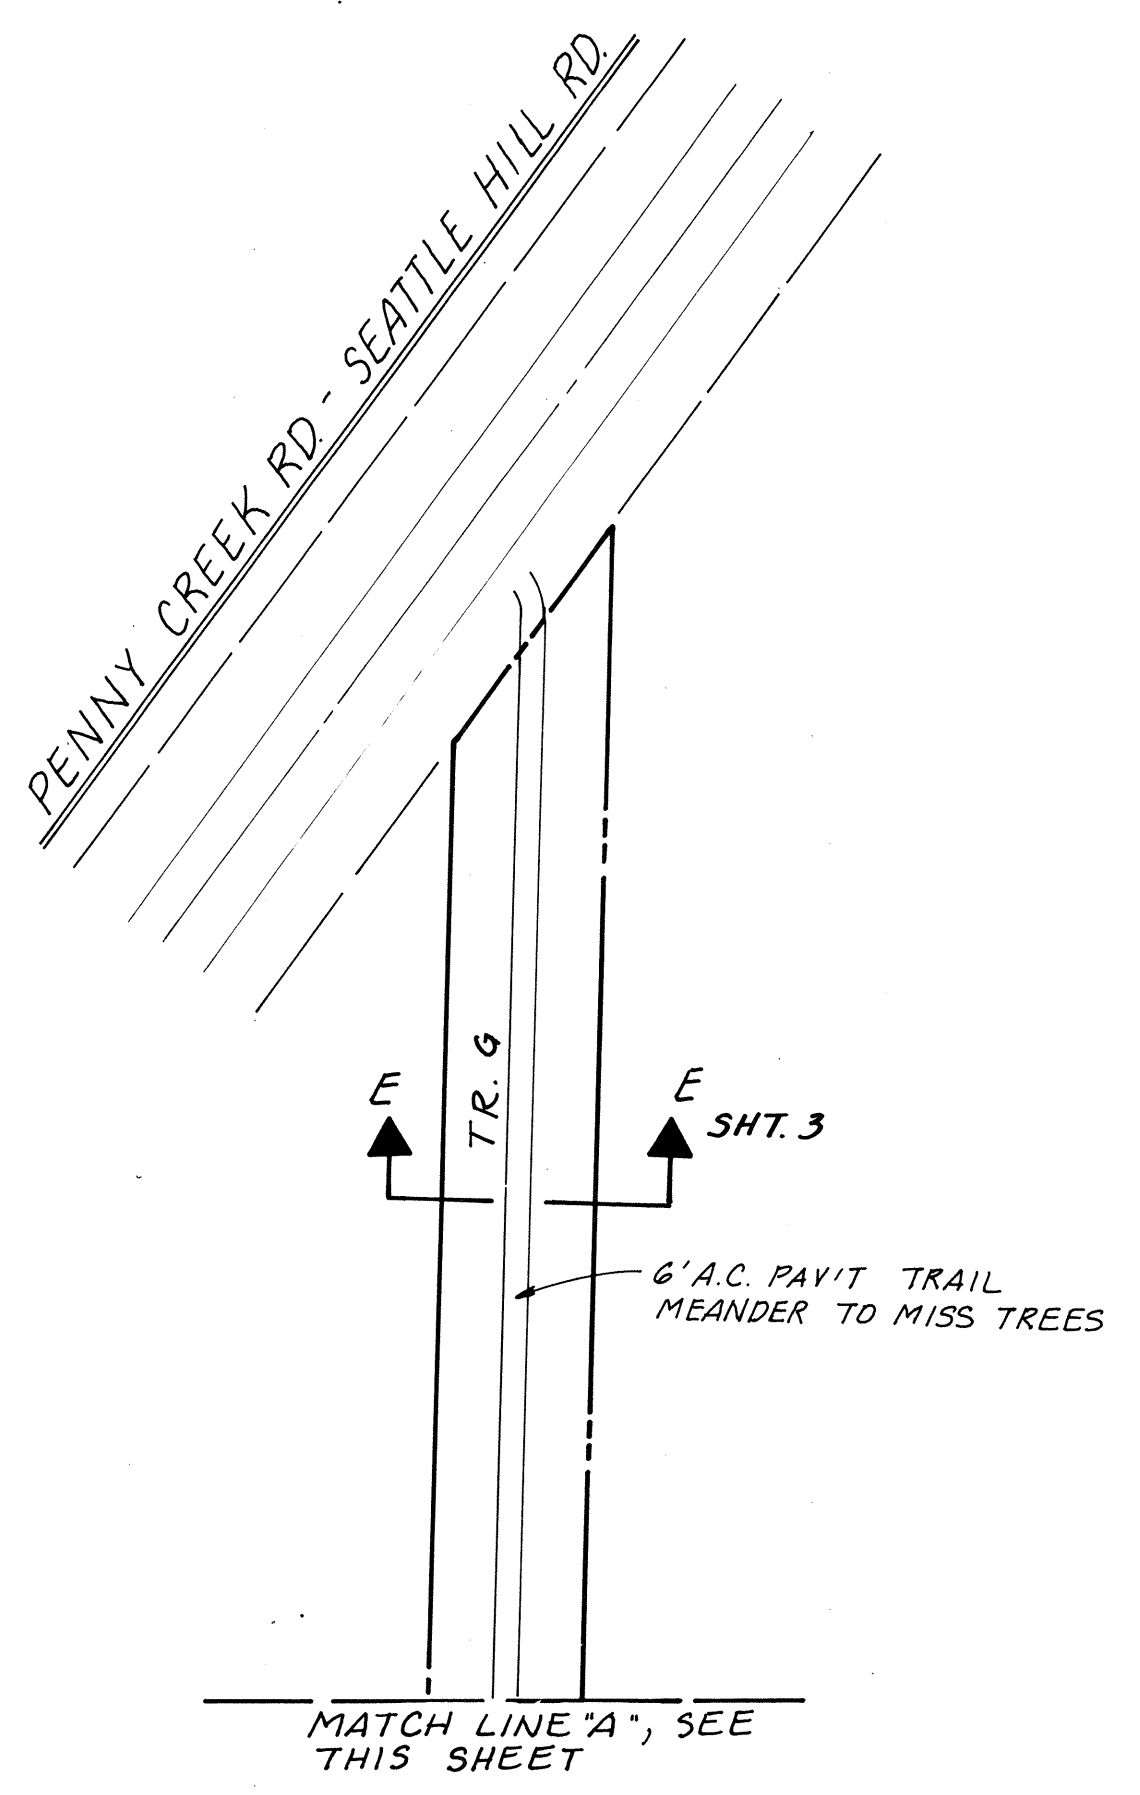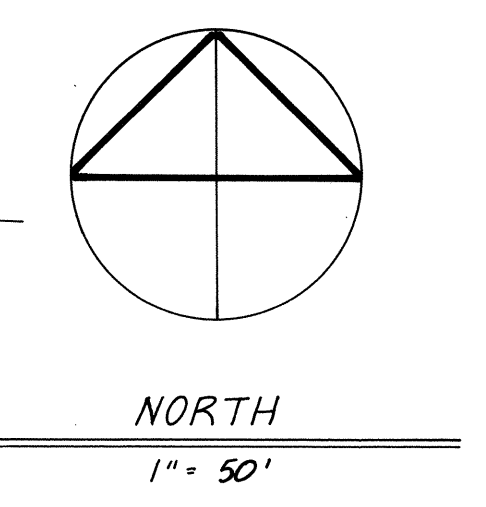

| CATCH BASIN SCHEDULE |        |                 |                         |                       |                    |
|----------------------|--------|-----------------|-------------------------|-----------------------|--------------------|
| Catch Basin No.      | Type   | Station Offset  | Rim/Grate Elev.(Rim/Gr) | Rim/Grate Elev.(I.E.) | Invert Elev.(I.E.) |
| 22.                  | II-48" | 1+60.00-13.25RT | Grate                   | 422.34                | 416.22-12" 416.71  |
| 22A.                 | Inlet  | 1+60.00-14.17LT | Grate                   | 422.42                | 419.80-8" 419.81   |
| 23.                  | I      | 3+11.00-14.17RT | Grate                   | 420.06                | 419.94-8" 419.82   |
| 23A.                 | Inlet  | 3+11.00-14.17LT | Grate                   | 420.71                | 417.59-8" 417.89   |
| 24.                  | I      | 4+58.00-14.17RT | Grate                   | 426.81                | 419.07-12" 418.93  |
| 24A.                 | Inlet  | 4+58.00-14.17LT | Grate                   | 422.82                | 419.40-8" 418.90   |
| 28.                  | II-48" | 3/4 Delta       | GRATE                   | 430.25                | 421.69-12" 420.95  |
| 28A.                 | Inlet  | 3/4 Delta       | Grate                   | 430.23                | 426.80-8" 421.75   |
| 29.                  | II-48" | 2+85.00-13.25L  | Grate                   | 429.36                | 423.45-12" 423.29  |
| 30.                  | I      | 4+08.00-14.17LT | Grate                   | 428.06                | 424.99-12" 425.21  |
| 30A.                 | Inlet  | 4+08.00-14.17RT | Grate                   | 428.08                | 424.90-8" 424.35   |
| 31.                  | I      | 5+58.00-14.17LT | Grate                   | 429.34                | 425.66-12" 425.93  |
| 31A.                 | Inlet  | 5+58.00-14.17RT | Grate                   | 429.34                | 425.99-8" 425.86   |
| 31B.                 | Future | 7+14.54-14.17LT | Conc/Scub               | 426.95                | 426.40             |

NOTES:  
 1. TRANSITION FROM ROLLED CURB (R.C.) TO VERTICAL CURB (V.C.) TO BE AT WHEELCHAIR RAMPS OR 1/2 Δ.  
 2. ALL CURB RADII ARE TO THE FACE OF VERTICAL CURB & GUTTER AND TO THE FLOWLINE (FL) OF ROLLED CURB & GUTTER.

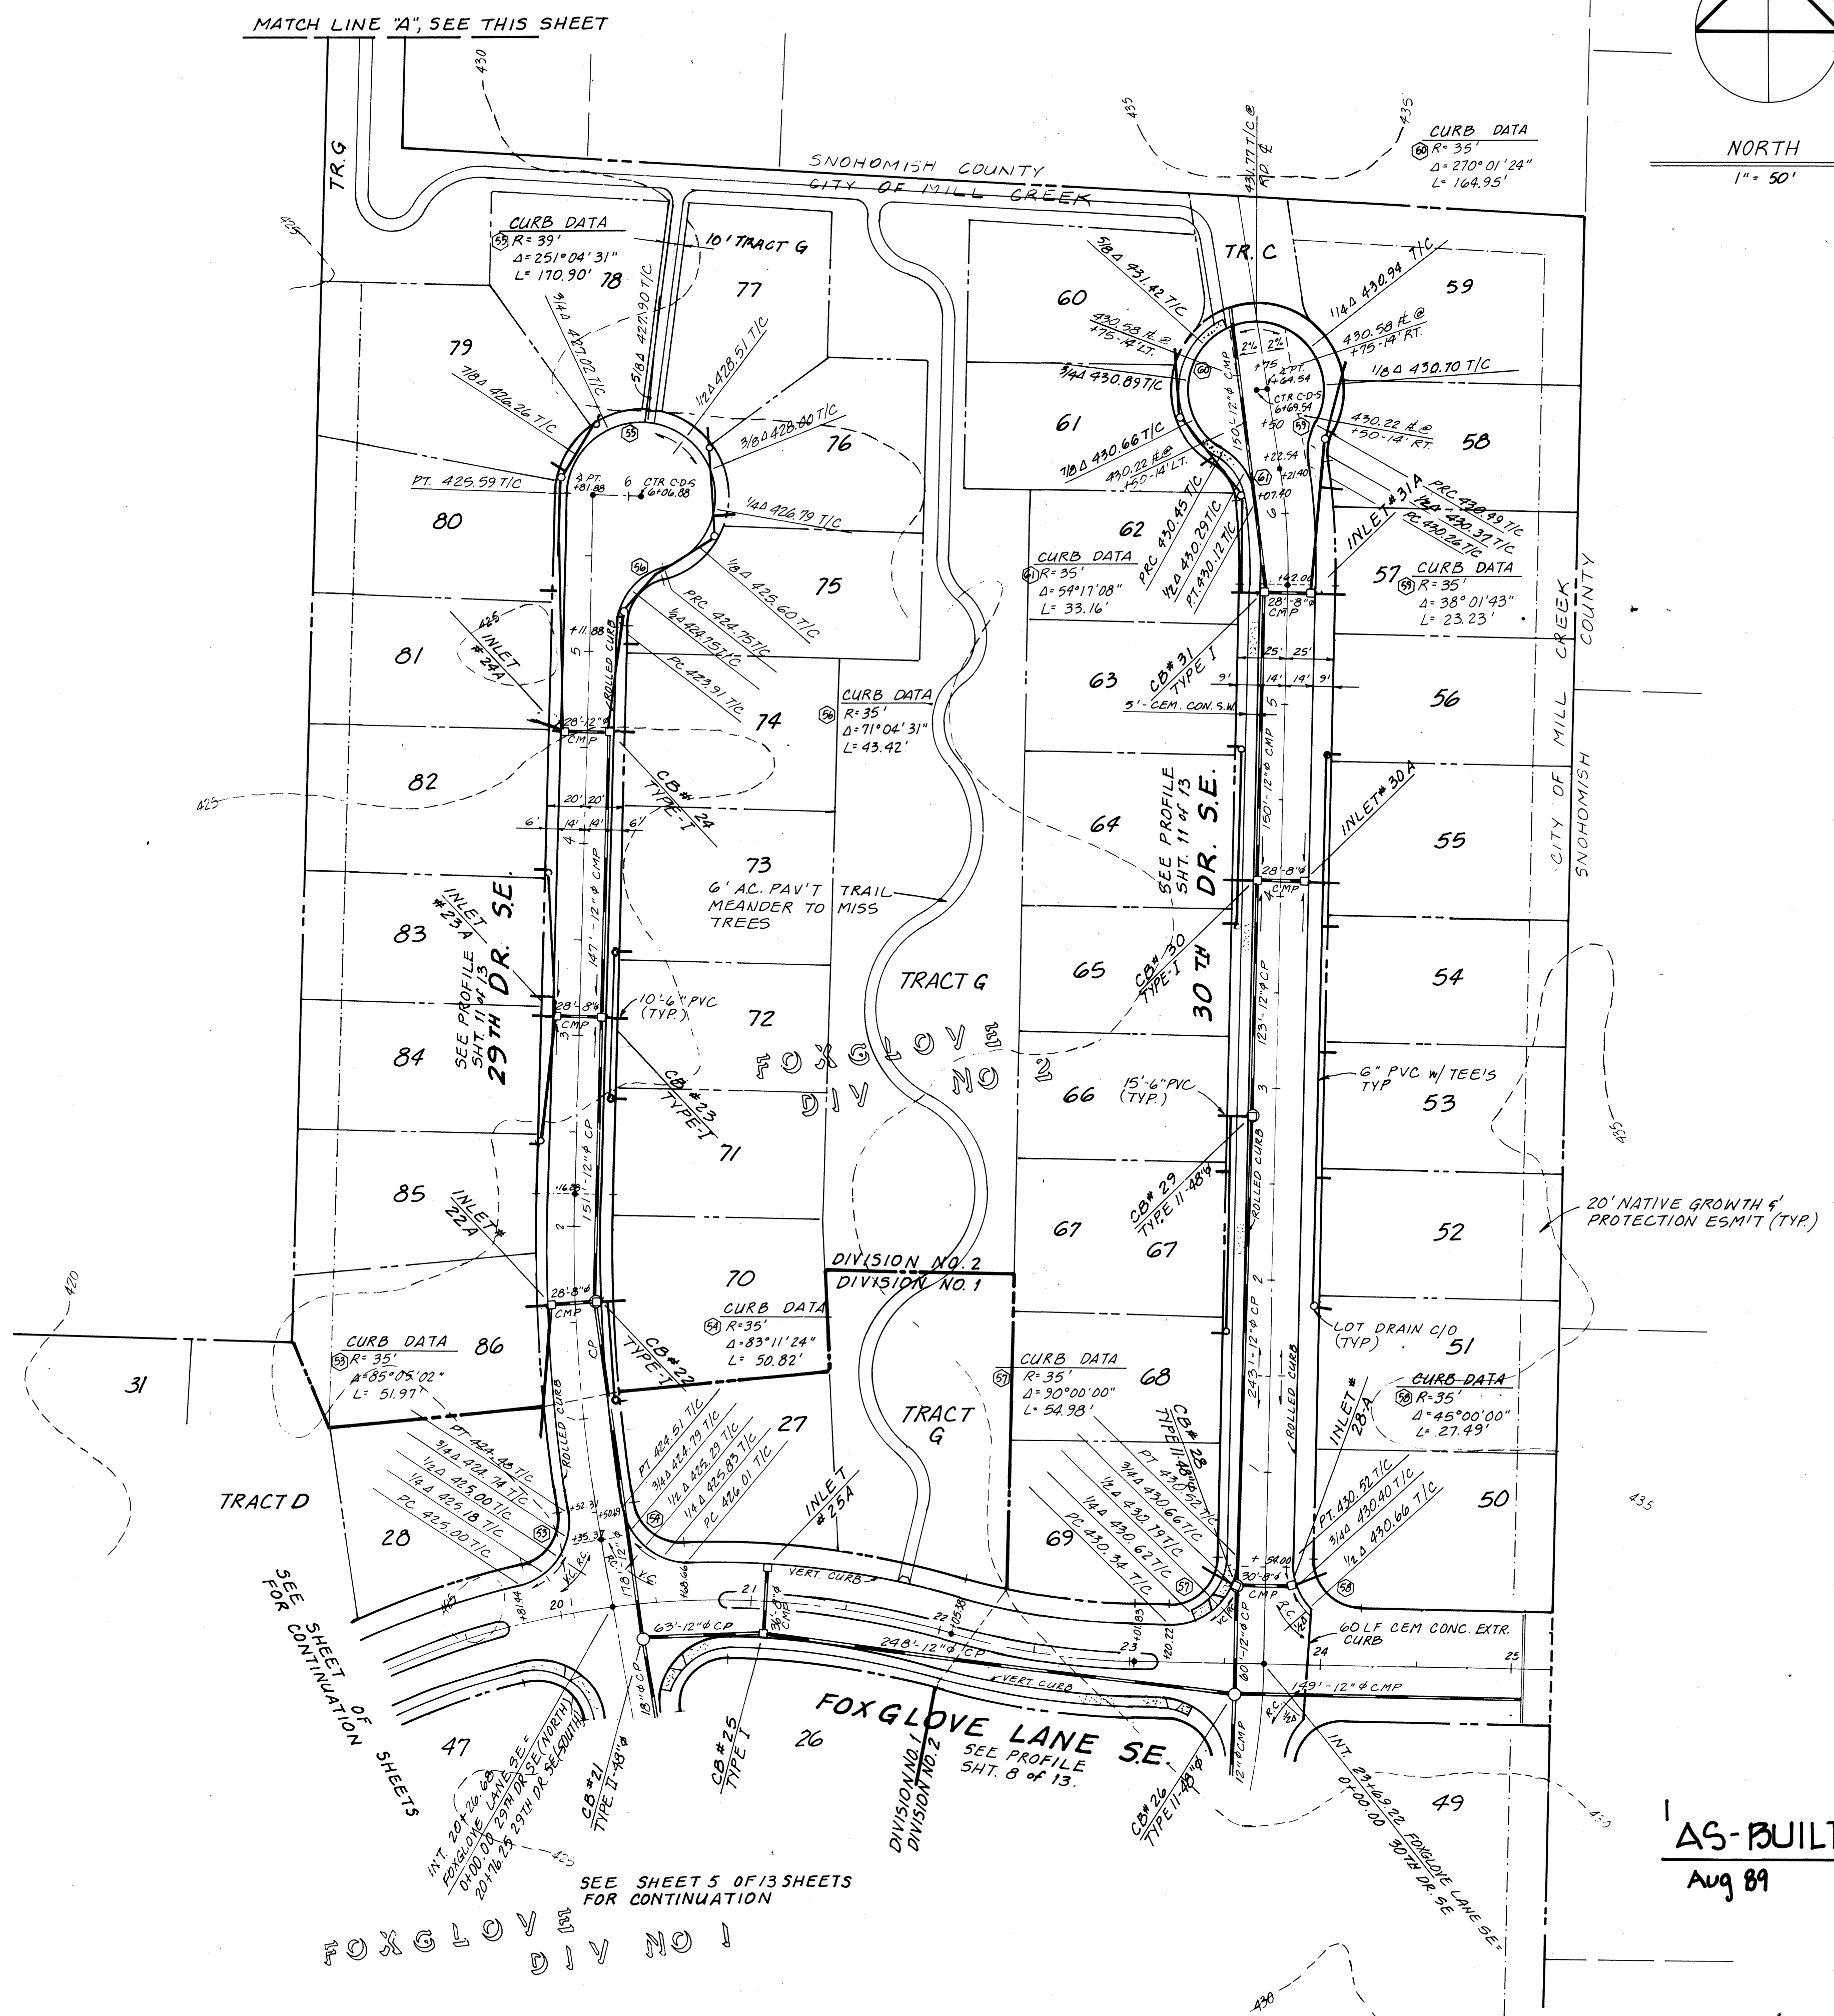

STREET AND STORM DRAINAGE PLAN  
 FOXGLOVE AT MILL CREEK  
 PACIFIC PROPERTIES, INC.  
 MILL CREEK, WASHINGTON




4. 5-9-88 50' lot sub & trail  
 3. 7-20-88 LOT DRAIN CLEANOUTS, TRACT G  
 2. 5-18-88 ADD LOT DRAIN CLEANOUTS  
 1. 4-21-88 REEL A9 PER CITY OF MILL CREEK

7 OF THIRTEEN SHEETS  
 SCALE 1"=50'H  
 DATE 3-7-88  
 FILE E7N1024

DESIGN J.B.  
 DRAWN J.B.  
 CHECKED A.K.H.



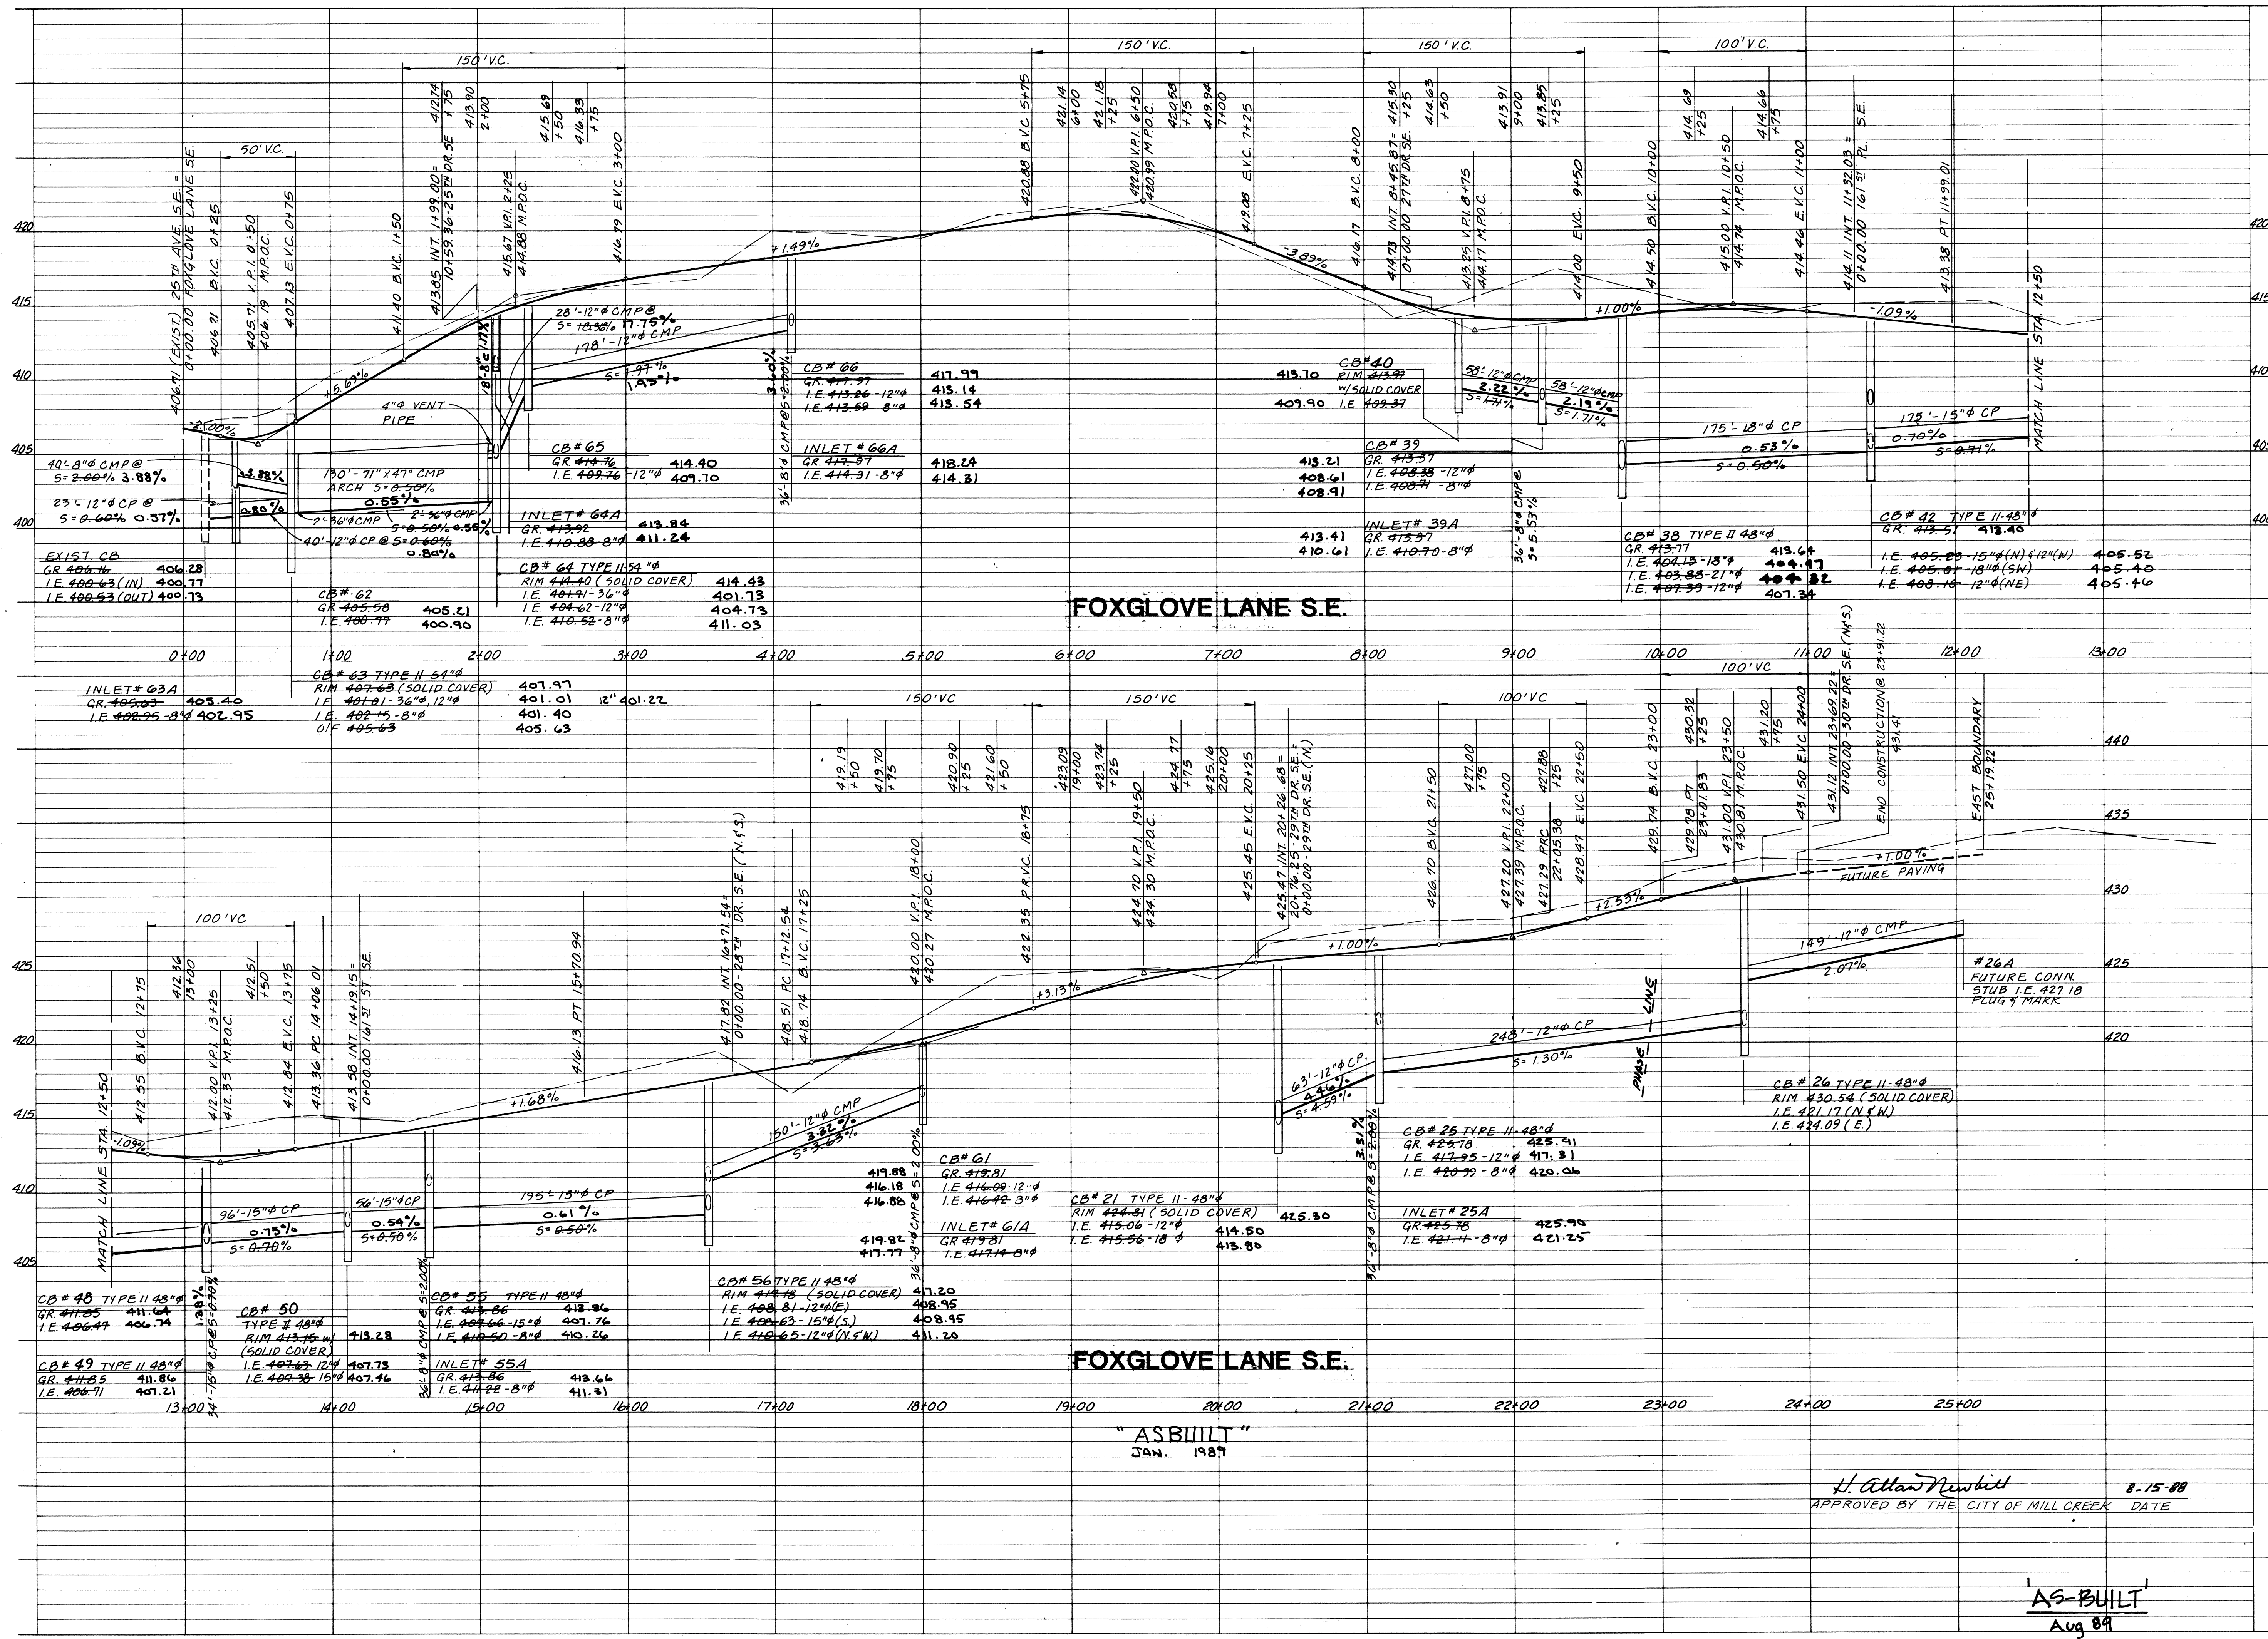

FOXGLOVE LANE S.E.

FOXGLOVE LANE S.E.

"AS-BUILT"  
JAN. 1987

H. Allan Newbill  
APPROVED BY THE CITY OF MILL CREEK DATE 8-15-88

"AS-BUILT"  
Aug 89

STREET AND  
STORM DRAINAGE  
PROFILES

FOXGLOVE AT MILL CREEK  
PACIFIC PROPERTIES, INC.  
MILL CREEK, WASHINGTON




DAVID EVANS AND ASSOCIATES, INC.  
301 NORTH PARK S.E. BELLEVUE, WA 98004 206/455-3571

8 OF THIRTEEN SHEETS  
SCALE 1"=50'H, 1"=5' V.  
DATE 3-7-88  
FILE ENW 024

Phase IV 'As-Built'  
2. G.G.G.B. KEY RD. GRADES  
1. 4-21-88 REV. AS PER CITY OF MILL CREEK  
CHECKED M.K.H.  
DESIGNED J.B.  
DRAWN J.B.



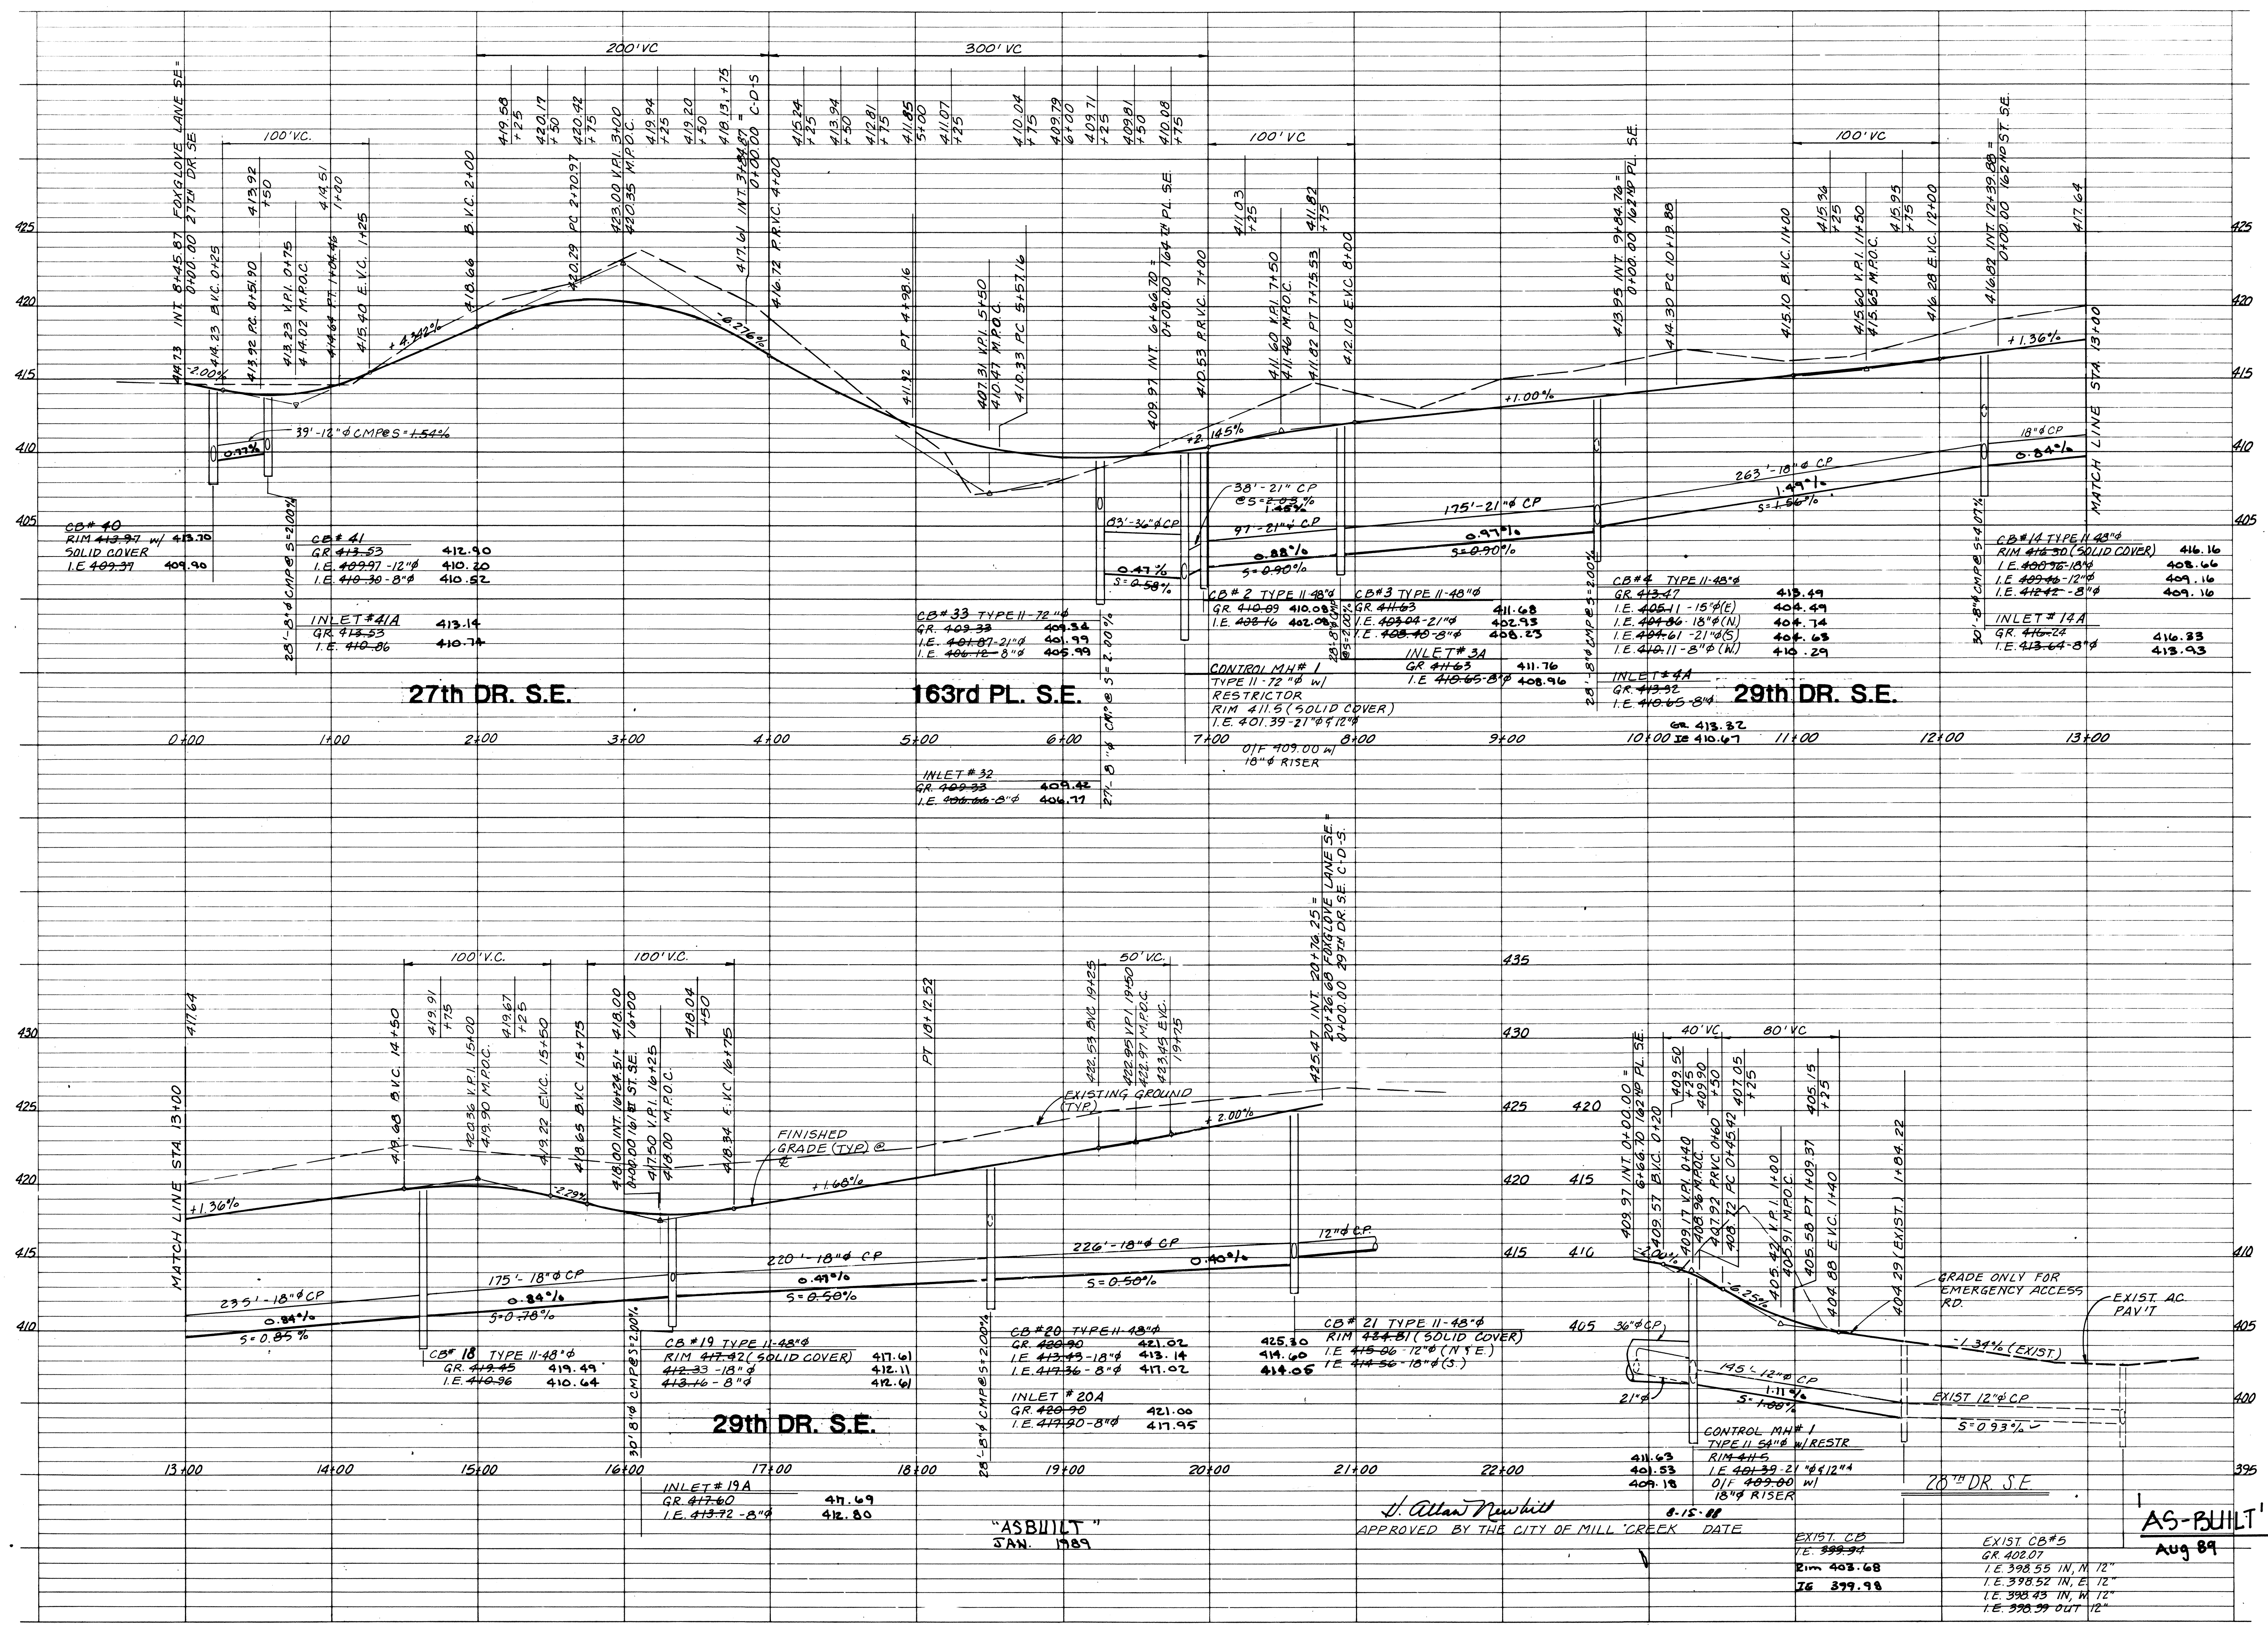

CB# 40

|                      |
|----------------------|
| RIM 413.97 w/ 413.70 |
| SOLID COVER          |
| I.E. 409.37          |
| 409.90               |

CB# 41

|                 |        |
|-----------------|--------|
| GR 413.53       | 412.90 |
| I.E. 409.97-12" | 410.20 |
| I.E. 419.30-8"  | 410.52 |

INLET #41A

|             |        |
|-------------|--------|
| GR 413.53   | 413.14 |
| I.E. 410.86 | 410.74 |

CB# 33 TYPE II-72"

|                 |        |
|-----------------|--------|
| GR 409.33       | 409.54 |
| I.E. 401.87-21" | 401.99 |
| I.E. 406.12-8"  | 405.99 |

INLET #32

|                |        |
|----------------|--------|
| GR 409.33      | 409.42 |
| I.E. 406.06-8" | 404.71 |

CB# 2 TYPE II-48"

|             |        |
|-------------|--------|
| GR 410.09   | 410.08 |
| I.E. 408.76 | 402.08 |

CB# 3 TYPE II-48"

|                    |        |
|--------------------|--------|
| GR 413.47          | 413.47 |
| I.E. 405.11-15"(E) | 404.49 |
| I.E. 404.86-18"(N) | 404.74 |
| I.E. 404.61-21"(S) | 404.63 |
| I.E. 410.11-8"(W)  | 410.29 |

INLET #3A

|                |        |
|----------------|--------|
| GR 413.47      | 411.76 |
| I.E. 410.65-8" | 408.96 |

INLET #4A


|                |        |
|----------------|--------|
| GR 413.32      | 413.32 |
| I.E. 410.65-8" | 410.47 |

CB# 14 TYPE II-48"

|                          |        |
|--------------------------|--------|
| RIM 416.50 (SOLID COVER) | 416.16 |
| I.E. 409.76-18"          | 408.66 |
| I.E. 409.86-12"          | 409.16 |
| I.E. 412.42-8"           | 409.16 |

INLET #14A

|                |        |
|----------------|--------|
| GR 416.24      | 416.23 |
| I.E. 413.64-8" | 413.93 |

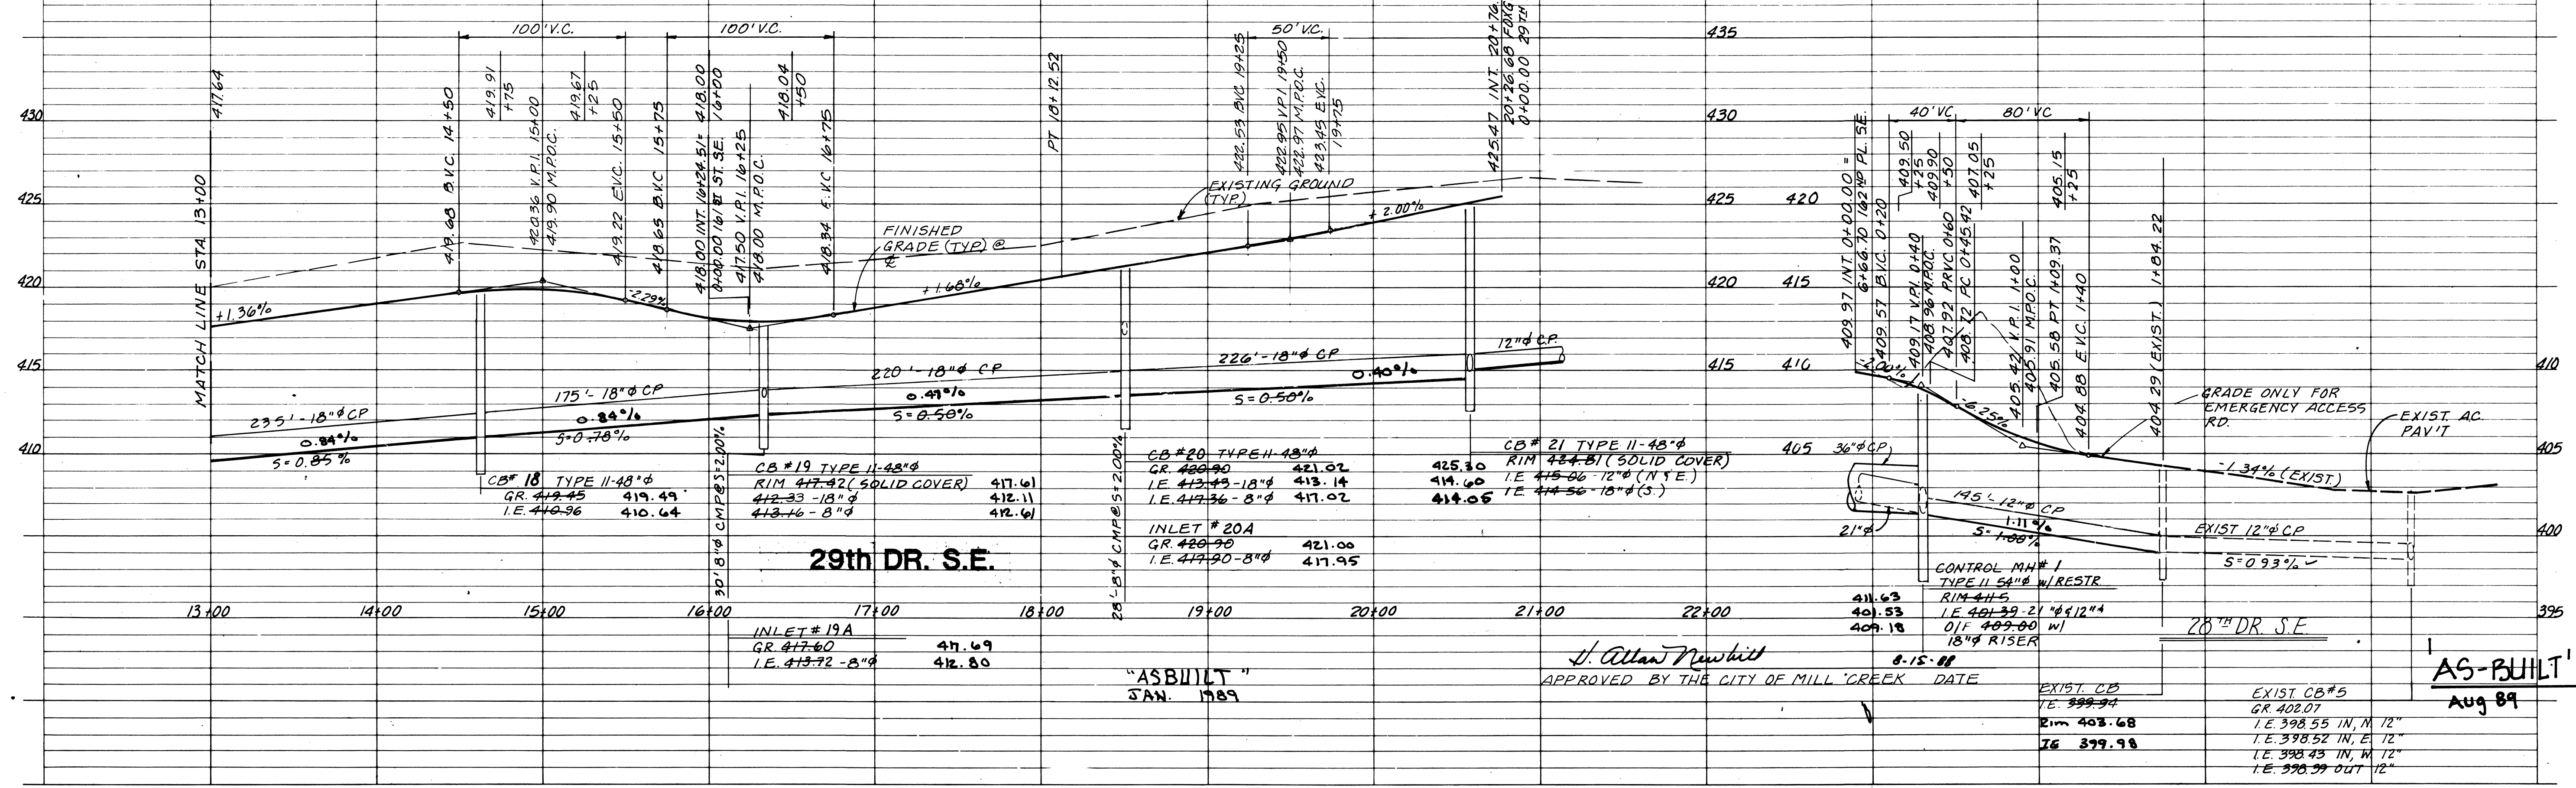

CB# 18 TYPE II-48"

|             |        |
|-------------|--------|
| GR 412.45   | 419.49 |
| I.E. 410.96 | 410.64 |

CB# 19 TYPE II-48"

|                          |        |
|--------------------------|--------|
| RIM 417.42 (SOLID COVER) | 417.61 |
| I.E. 413.33-18"          | 412.11 |
| I.E. 417.36-8"           | 417.02 |

INLET #20A

|                |        |
|----------------|--------|
| GR 420.90      | 421.00 |
| I.E. 417.90-8" | 417.95 |

INLET #19A

|                |        |
|----------------|--------|
| GR 417.60      | 417.69 |
| I.E. 413.72-8" | 412.80 |

CB# 21 TYPE II-48"

|                          |        |
|--------------------------|--------|
| RIM 414.81 (SOLID COVER) | 415.30 |
| I.E. 415.06-12"(N/E)     | 414.60 |
| I.E. 414.56-18"(S)       | 414.06 |

AS-BUILT  
JAN. 1989

APPROVED BY THE CITY OF MILL CREEK DATE 8-15-88

EXIST. CB

|                       |        |
|-----------------------|--------|
| GR 402.07             | 399.94 |
| Rim 403.68            | 403.68 |
| I.E. 398.55 IN, M 12" | 398.55 |
| I.E. 398.52 IN, E 12" | 398.52 |
| I.E. 398.43 IN, W 12" | 398.43 |
| I.E. 398.39 OUT 12"   | 398.39 |

EXIST. CB#5

|                       |        |
|-----------------------|--------|
| GR 402.07             | 399.94 |
| Rim 403.68            | 403.68 |
| I.E. 398.55 IN, M 12" | 398.55 |
| I.E. 398.52 IN, E 12" | 398.52 |
| I.E. 398.43 IN, W 12" | 398.43 |
| I.E. 398.39 OUT 12"   | 398.39 |

STREET AND STORM DRAINAGE PROFILES

FOXGLOVE AT MILL CREEK

PACIFIC PROPERTIES, INC.

MILL CREEK, WASHINGTON



DAVID EVANS AND ASSOCIATES, INC.

501 WASHINGTON ST. BELLEVUE, WA 98004

AS-BUILT

AUG 89

9 OF THIRTEEN SHEETS

SCALE 1"=50'H, 1"=5' V.

DATE 3-7-89

FILE ENW 024

DESIGNED N.K.H.

CHECKED J.D.

DRAWN J.D.

REV. AS PER CITY OF MILL CREEK

REV. 6-6-88

REV. 12-1-88

REV. 7-12-88


Phase IV, AS-BUILT

REV. PIPE SIZE (21" to 24" Ø) 5/88

REV. R.D. GRADES

REV. 8-15-88



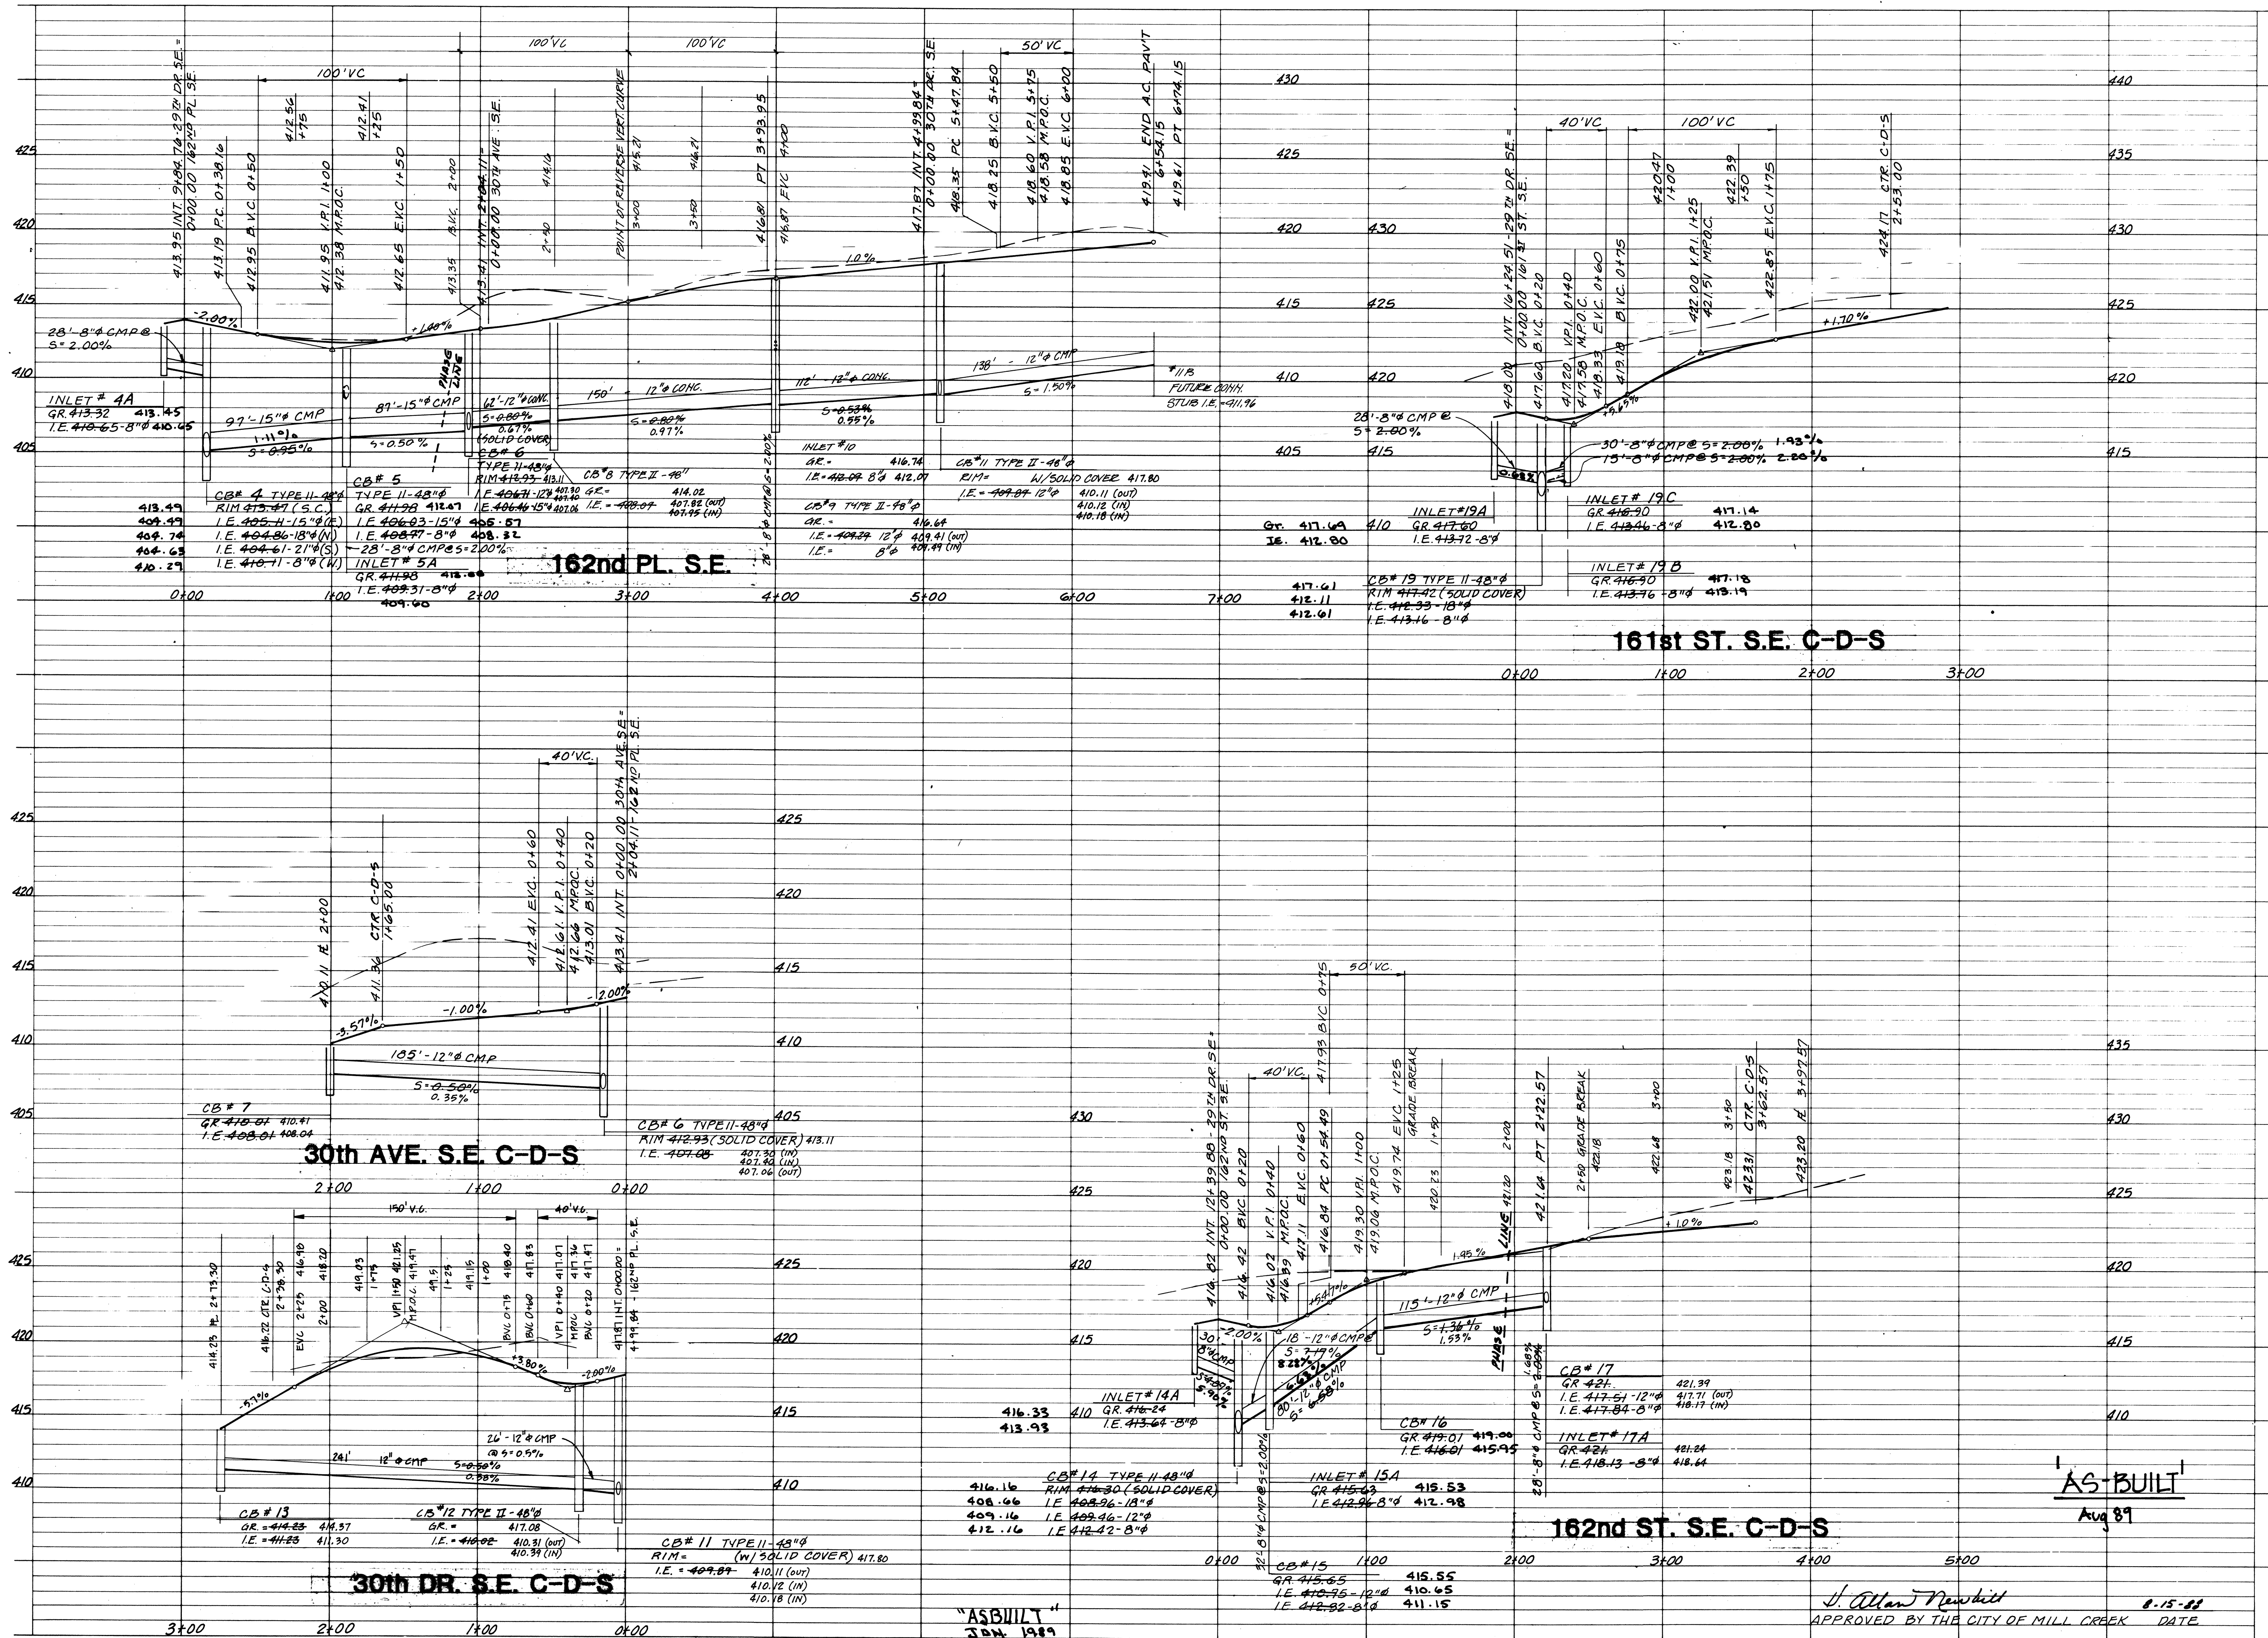

J. Allen Newhall  
APPROVED BY THE CITY OF MILL CREEK  
DATE 8-15-89

**HIGHLANDS**

STREET AND  
STORM DRAINAGE  
PROFILES


FOXGLOVE AT MILL CREEK  
PACIFIC PROPERTIES, INC.  
MILL CREEK, WASHINGTON



**David Evans and Associates, Inc.**  
301 NORTH WALKER S.E. BELLEVUE, WA 98004 206-465-3571

|             |                                |
|-------------|--------------------------------|
| NO. 10      | PHASE IV AS-BUILT              |
| DATE 3-7-88 | REV. AS PER CITY OF MILL CREEK |
| BY ENW 024  | REV. 10-11-88                  |
| CHECKED     | DATE                           |



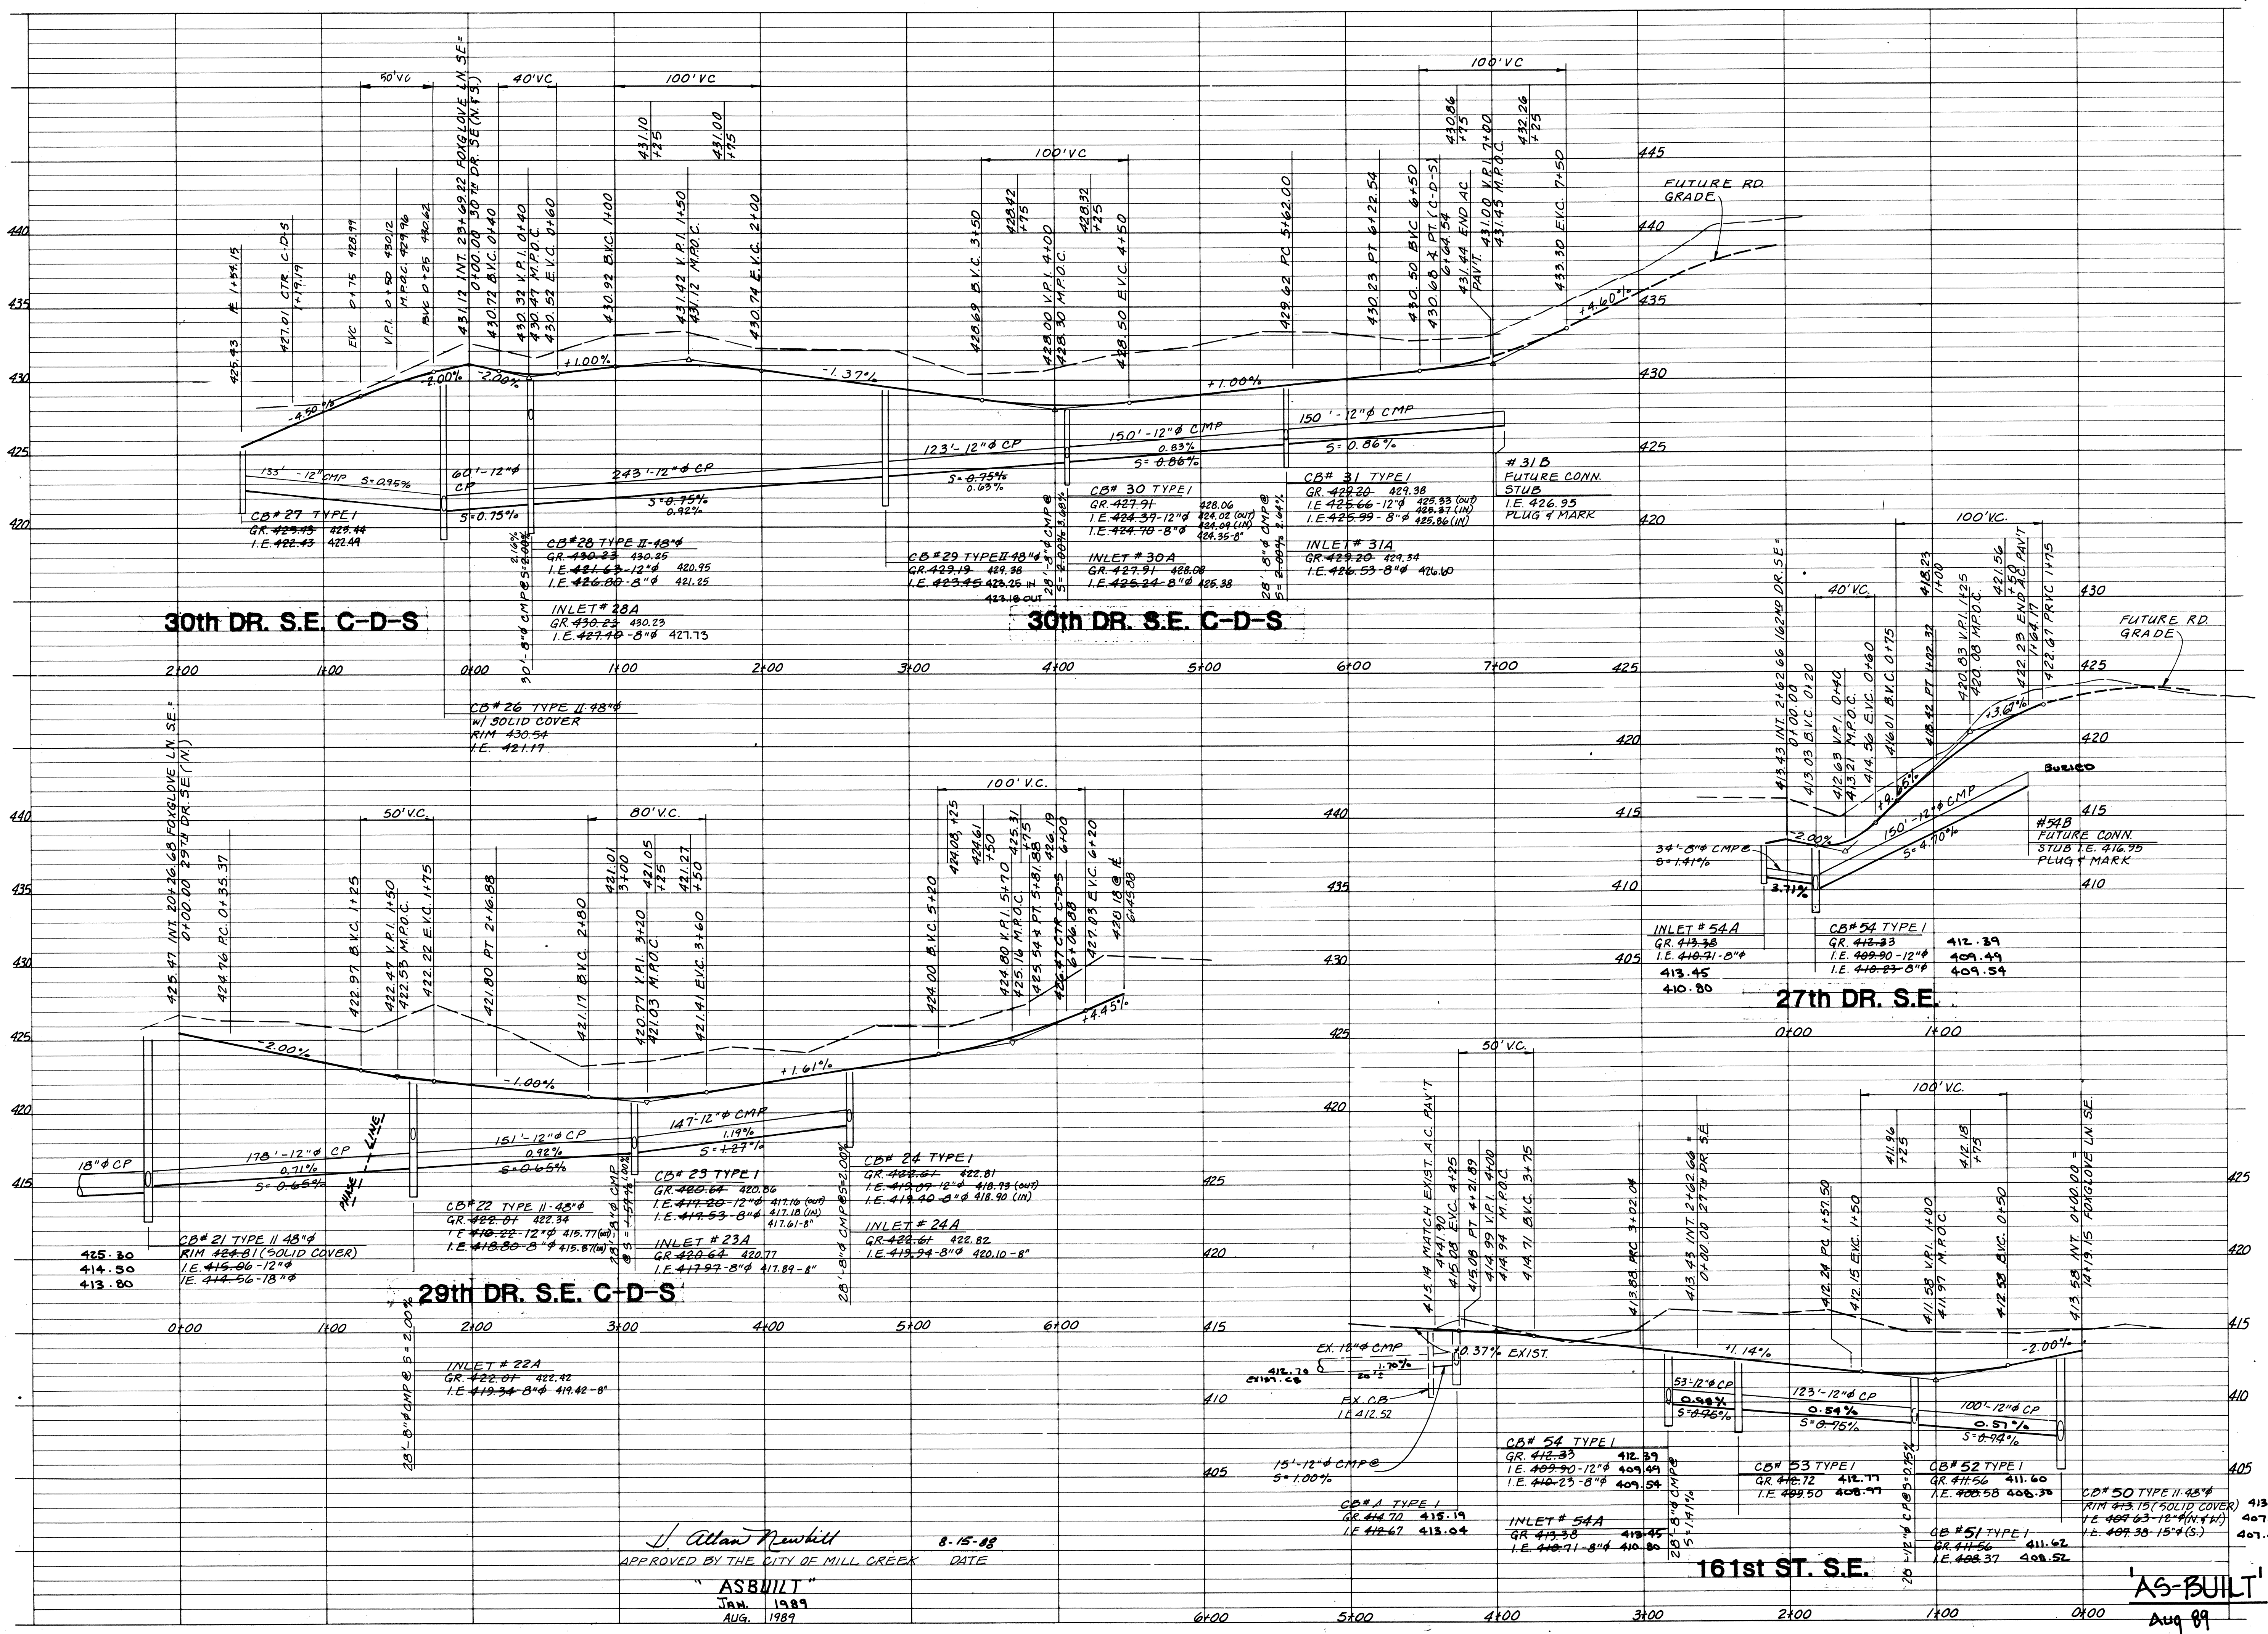

30th DR. S.E. C-D-S

30th DR. S.E. C-D-S

27th DR. S.E.

29th DR. S.E. C-D-S

161st ST. S.E.

AS-BUILT


APPROVED BY THE CITY OF MILL CREEK  
 DATE 8-15-83  
 ASBUILT  
 Jan. 1989  
 Aug. 1989

STREET AND  
 STORM DRAINAGE  
 PROFILES  
 FOXGLOVE AT MILL CREEK  
 PACIFIC PROPERTIES, INC.  
 MILL CREEK, WASHINGTON



DAVID EVANS AND ASSOCIATES, INC.  
 501 10TH AVE. S.E. BELLEVUE, WA 98004 206/485-3671  
 OF THIRTEEN SHEETS  
 AUG. 89 PHASE IV AS-BUILT  
 4-21-88 REV. AS PRES. CITY OF MILL CREEK  
 J.D. J.D. N.K.H.  
 DATE 3-7-88 DRAWN J.D. CHECKED N.K.H.  
 SCALE 1" = 50' H, 1" = 5' V  
 SHEET ENH 024



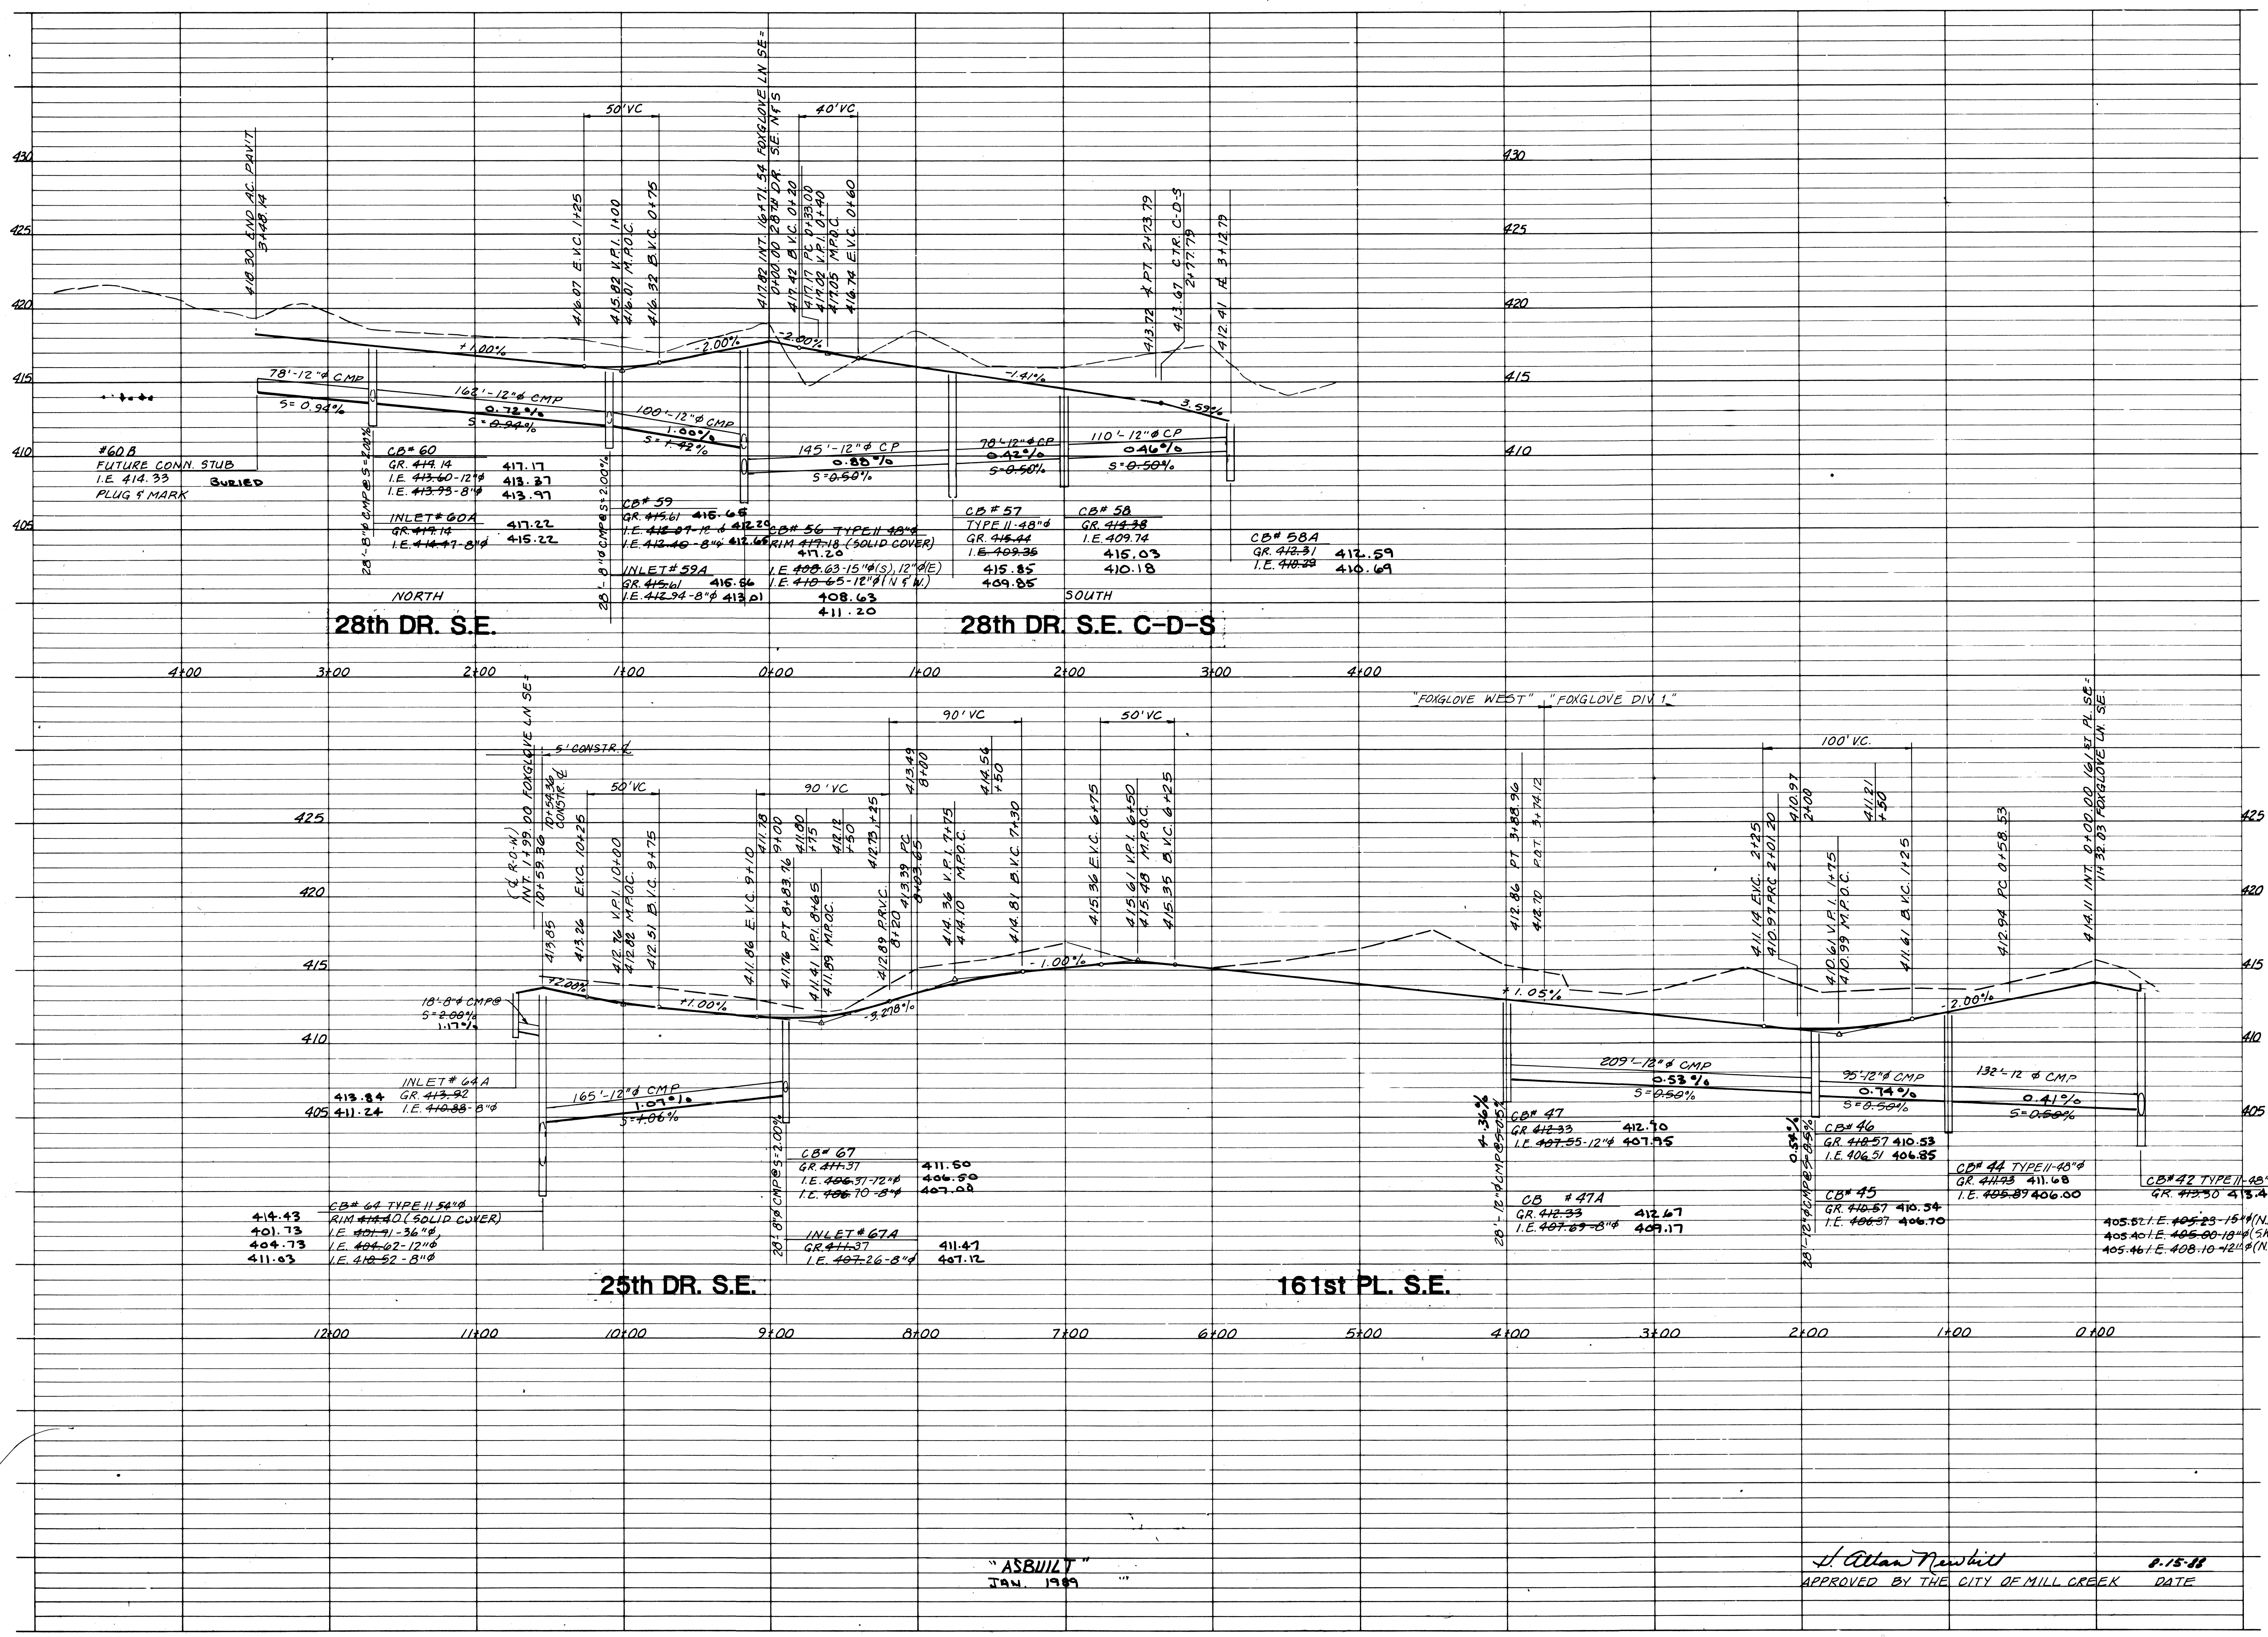


J. Allan Newbill  
APPROVED BY THE CITY OF MILL CREEK  
DATE 8-15-88





**DAVID EVANS AND ASSOCIATES, INC.**  
301 10TH AVE. SE. BELLEVUE, WA 98004-3000

13 OF THIRTEEN SHEETS  
DATE: 8-15-88  
DRAWN: J.D.  
CHECKED: J.D.  
DESIGNED: M.K.H.

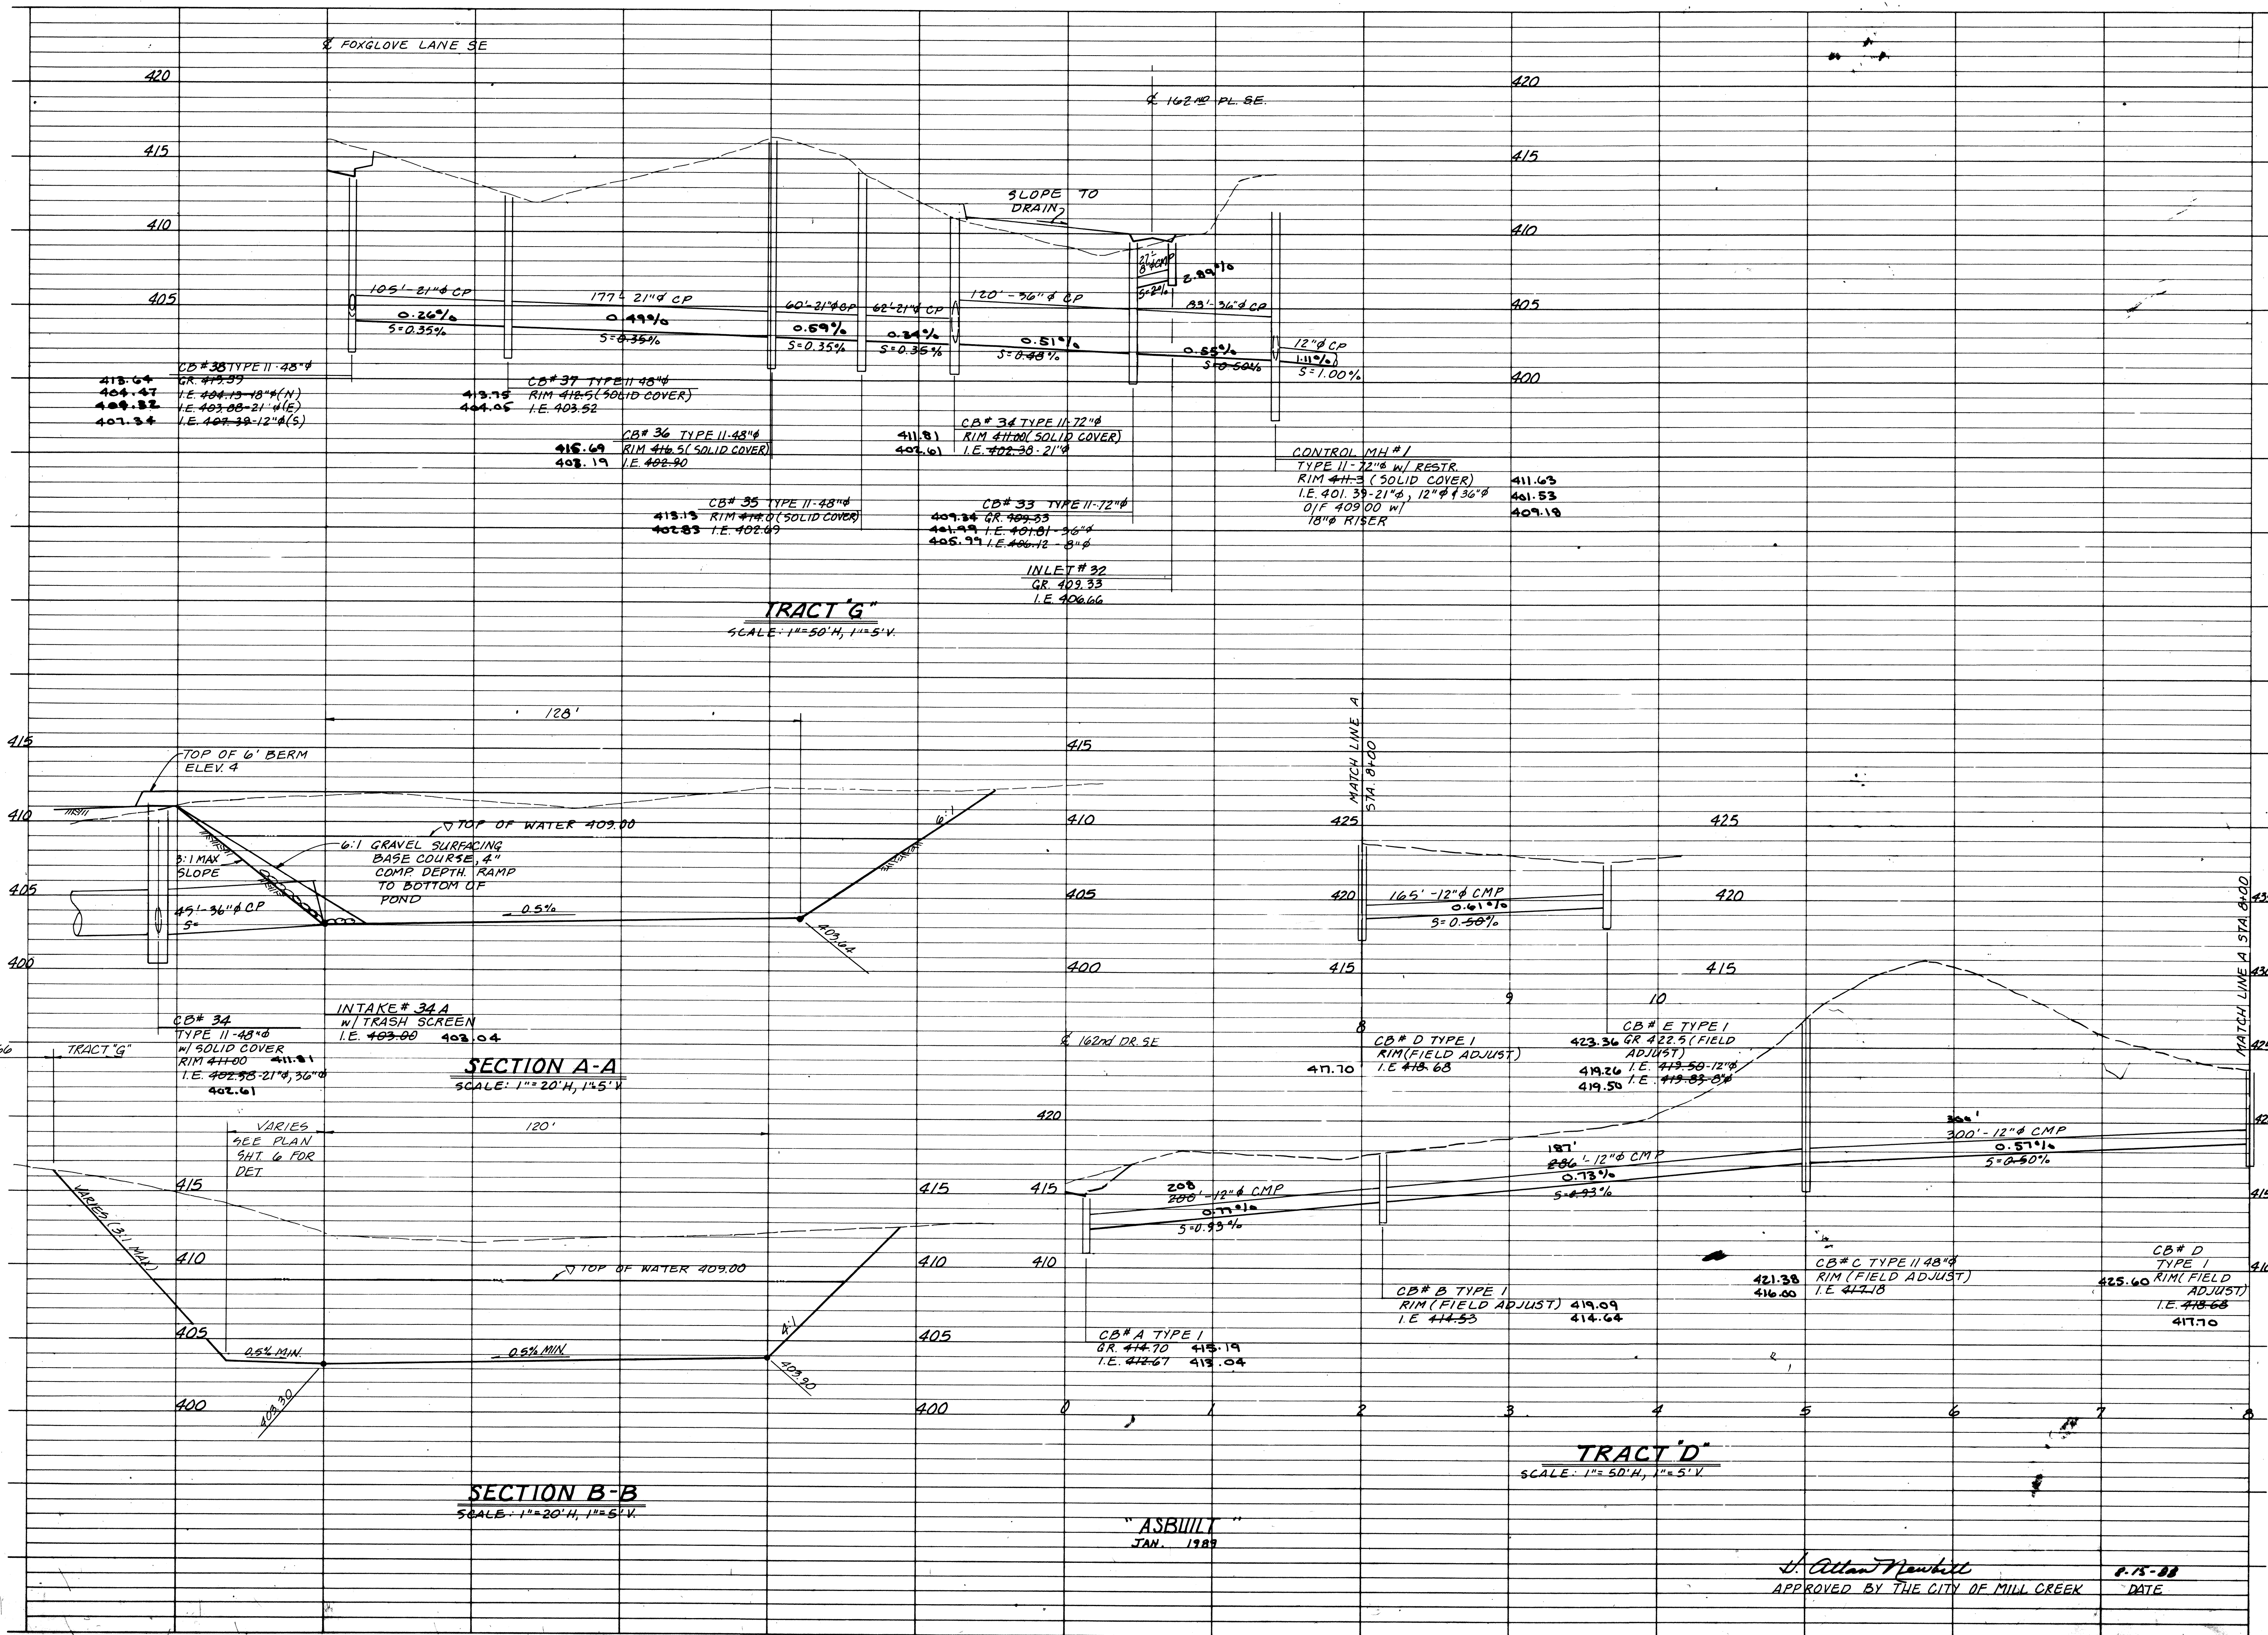

APPROVED BY THE CITY OF MILL CREEK  
DATE: 8-15-88

HIGHLANDS